

STATE ENGINEER  
Salem, Oregon

# Well Record

STATE WELL NO. 14/5W-22B  
COUNTY Benton  
APPLICATION NO. GR-3927

*6838*

OWNER: Arnold Eberlein


MAILING ADDRESS: Route 3,

LOCATION OF WELL: Owner's No. \_\_\_\_\_

CITY AND STATE: Junction City, Oregon

NW ¼ NE ¼ Sec. 22 T. 14 S., R. 5 W., W.M.

Bearing and distance from section or subdivision  
corner 281' W., S. 0°09' E. 836' to SW Cor.  
Samuel H. Oliver DIC 47

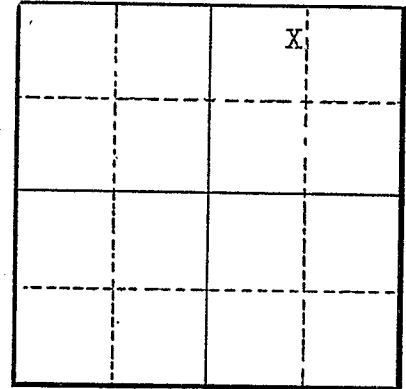

Section 22

Altitude at well \_\_\_\_\_

TYPE OF WELL: Driven Date Constructed 1952

Depth drilled 21 ft. Depth cased 21 ft.

### CASING RECORD:

4 inch steel casing set to 21 feet

### FINISH:

slotted, size and number unknown from 18 to 21 feet

### AQUIFERS:

### WATER LEVEL:

12 feet below surface

PUMPING EQUIPMENT: Type 2 x 1½ centrifugal H.P. 36  
Capacity 200 G.P.M.

### WELL TESTS:

Drawdown \_\_\_\_\_ ft. after \_\_\_\_\_ hours \_\_\_\_\_ G.P.M.  
Drawdown \_\_\_\_\_ ft. after \_\_\_\_\_ hours \_\_\_\_\_ G.P.M.

USE OF WATER Irrigation Temp. \_\_\_\_\_ °F., 19 \_\_\_\_\_

SOURCE OF INFORMATION Well Registration Statement Cert. # GR-3562

DRILLER or DIGGER \_\_\_\_\_

### ADDITIONAL DATA:

Log \_\_\_\_\_ Water Level Measurements \_\_\_\_\_ Chemical Analysis \_\_\_\_\_ Aquifer Test \_\_\_\_\_

### REMARKS: