

STATE ENGINEER
Salem, Oregon

Well Record

Bent
6745

STATE WELL NO. 14/5W-22R
COUNTY Benton
APPLICATION NO. GR-1475

GR- 1424

OWNER: Melvin Becker


MAILING ADDRESS: Rt. 3

LOCATION OF WELL: Owner's No.

CITY AND STATE: Junction City, Oregon

SE 1/4 SE 1/4 Sec. 22 T. 14 S., R. 5 W., W.M.

Bearing and distance from section or subdivision corner S. 15° 30' E. 561' to SE cor. of Sec. 22

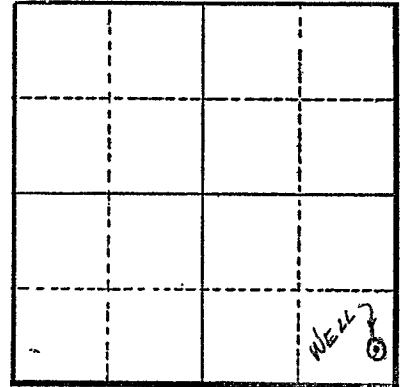

Section 22

Altitude at well 270'

TYPE OF WELL: Driven Date Constructed 1947

Depth drilled 18' Depth cased 18'

CASING RECORD:

2 - 1 1/2" pipes connected

FINISH:

Perforated from 15' to 18'

AQUIFERS:

WATER LEVEL:

10'

PUMPING EQUIPMENT: Type 1 1/2" x 2" Cent. H.P. 5
Capacity 100 G.P.M.

WELL TESTS:

Drawdown ft. after hours G.P.M.
Drawdown ft. after hours G.P.M.

USE OF WATER Irrigation Temp. °F. 19

SOURCE OF INFORMATION GR Record

DRILLER or DIGGER

ADDITIONAL DATA:

Log N.A. Water Level Measurements Chemical Analysis Aquifer Test

REMARKS:

Irrigation of 17 acres.