

STATE ENGINEER
Salem, Oregon

Well Record

Benton
6856

STATE WELL NO. 14/5W-23E
COUNTY Benton
APPLICATION NO. GR-1376

GR- 1333

OWNER: William A. & Zelma L. Goracke


MAILING ADDRESS: Rt. 3

LOCATION OF WELL: Owner's No. _____

CITY AND STATE: Junction City, Oregon

SW $\frac{1}{4}$ NW $\frac{1}{4}$ Sec. 23 T. 14 ^{N.} S., R. 5 ^{W.} W.M. ^{EX}

Bearing and distance from section or subdivision corner 2257' N48°15'E. to N $\frac{1}{4}$ cor. Sec. 23.

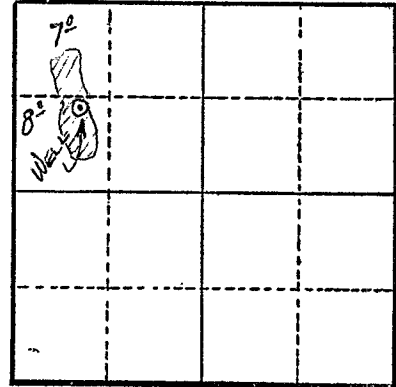

Section 23

Altitude at well 240 ft.

TYPE OF WELL: Driven Date Constructed 1952

Depth drilled 21 ft. Depth cased 21 ft.

CASING RECORD:

4 inch

FINISH:

Slotted perforations from 10 to 21 ft.

AQUIFERS:

WATER LEVEL:

9 ft.

PUMPING EQUIPMENT: Type 1 $\frac{1}{2}$ x 2 in. Cent. H.P. 5
Capacity 125 G.P.M.

WELL TESTS:

Drawdown 4 ft. after _____ hours 200 G.P.M.

Drawdown _____ ft. after _____ hours _____ G.P.M.

USE OF WATER Irrigation Temp. _____ °F. _____, 19____

SOURCE OF INFORMATION G. R. Record

DRILLER or DIGGER _____

ADDITIONAL DATA:

Log N.A. Water Level Measurements _____ Chemical Analysis _____ Aquifer Test _____

REMARKS:

Irrigation of 15 acres.