

STATE ENGINEER
Salem, Oregon

Well Record

STATE WELL NO. 14/5W-23K
COUNTY Benton
APPLICATION NO. GR-4118

OWNER: Martin C. Coracke

MAILING

ADDRESS: Route 3

LOCATION OF WELL: Owner's No.


CITY AND

STATE: Junction City, Oregon

NW 1/4 SE 1/4 Sec. 23 T. 14 S. R. 5 W., W.M.

Bearing and distance from section or subdivision

corner 369' N. 27° E. from SE Cor. of NW 1/4 SE 1/4

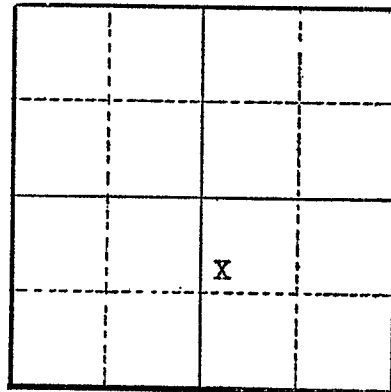

Section 23

Altitude at well

TYPE OF WELL: Driven Date Constructed 1942

Depth drilled 21 ft. Depth cased 21 ft.

CASING RECORD:

2 inch steel casing set to 21 feet

FINISH:

perforated from 16 to 21 feet

AQUIFERS:

WATER LEVEL:

15 feet below surface

PUMPING EQUIPMENT: Type 2 x 1/2 centrifugal
Capacity 120 G.P.M.

H.P. 3

WELL TESTS:

Drawdown ft. after hours G.P.M.

Drawdown ft. after hours G.P.M.

USE OF WATER Irrigation Temp. °F. 19

SOURCE OF INFORMATION Well Registration Statement Cert. # GR-3701

DRILLER or DIGGER

ADDITIONAL DATA:

Log Water Level Measurements Chemical Analysis Aquifer Test

REMARKS: