

STATE ENGINEER
Salem, Oregon

Well Record

STATE WELL NO. 14/5W-230
COUNTY Benton
APPLICATION NO. GR-4117

OWNER: Robert N. Goracke

MAILING

ADDRESS: Route 3

LOCATION OF WELL: Owner's No. _____

CITY AND

STATE: Junction City, Oregon

SW $\frac{1}{4}$ SE $\frac{1}{4}$ Sec. 23 T. 14 S., R. 5 W., W.M.


Bearing and distance from section or subdivision

corner 1050' S. 55° 45' E. from NW Cor.

Altitude at well _____

TYPE OF WELL: Drilled Date Constructed 1950

Depth drilled 22 ft. Depth cased 21 ft.

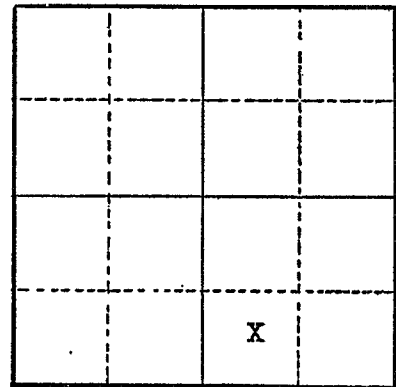

Section 23

CASING RECORD:

two 4" casings spaced 6" apart from 0 to 21 feet

FINISH:

perforated from 17 to 22 feet

AQUIFERS:

WATER LEVEL:

15 feet below surface

PUMPING EQUIPMENT: Type 2 x 1 $\frac{1}{2}$ centrifugal H.P. 3
Capacity 120 G.P.M.

WELL TESTS:

Drawdown 1 ft. after _____ hours 1200 G.P.M.

Drawdown _____ ft. after _____ hours _____ G.P.M.

USE OF WATER Irrigation Temp. _____ °F., 19 _____

SOURCE OF INFORMATION Well Registration Statement Cert. # GR-3700

DRILLER or DIGGER _____

ADDITIONAL DATA:

Log _____ Water Level Measurements _____ Chemical Analysis _____ Aquifer Test _____

REMARKS: