

STATE ENGINEER
Salem, Oregon

Well Record

STATE WELL NO. 14/5W - 24F
COUNTY BENTON
APPLICATION NO. GR-2154

6-6385
6-6384
6868

OWNER: O. W. Fawver


MAILING ADDRESS: Rt. 3, Box 671

LOCATION OF WELL: Owner's No. _____

CITY AND STATE: Junction City, Oregon

SE $\frac{1}{4}$ NW $\frac{1}{4}$ Sec. 24 T. 14 S., R. 5 W., W.M.

Bearing and distance from section or subdivision corner S. 55° 45' E. 452' hence W. 35.125 chains hence S. 10.828 chains

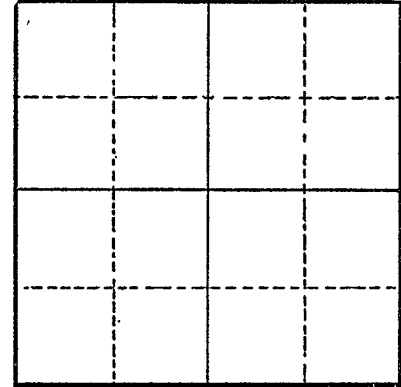

Section _____

Altitude at well _____

TYPE OF WELL: Driven Date Constructed 1947

Depth drilled 27 Depth cased 27

CASING RECORD:

4-Inches

FINISH:

Perforations from 21 to 27

AQUIFERS:

WATER LEVEL:

12-Feet

PUMPING EQUIPMENT: Type Fairbanks Morse H.P. 25
Capacity 350 G.P.M.

WELL TESTS:

Drawdown _____ ft. after _____ hours Pumping 350 G.P.M.
Drawdown _____ ft. after _____ hours _____ G.P.M.

USE OF WATER Irrigation Temp. _____ °F. _____, 19____

SOURCE OF INFORMATION GR-2064

DRILLER or DIGGER _____

ADDITIONAL DATA:

Log _____ Water Level Measurements _____ Chemical Analysis _____ Aquifer Test _____

REMARKS: