

STATE ENGINEER
Salem, Oregon

Well Record

STATE WELL NO. 14/5W-25D
COUNTY Benton
APPLICATION NO. GR-1471

GR-1420 6879

OWNER: Harold & Elma Lister


MAILING ADDRESS: Rt. 3

LOCATION OF WELL: Owner's No. _____

CITY AND STATE: Junction City, Oregon

NW $\frac{1}{4}$ NW $\frac{1}{4}$ Sec. 25 T. 14 S., R. 5 W., W.M.

Bearing and distance from section or subdivision corner 1650' N. & 985' E. from W $\frac{1}{4}$ cor. Sec. 25.

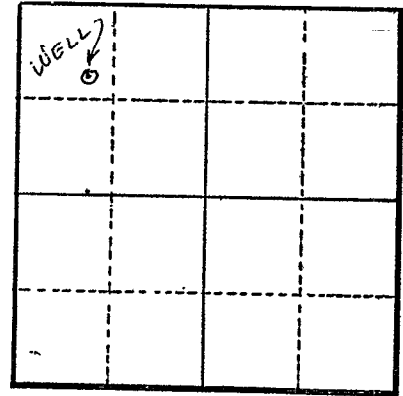

Section 25

Altitude at well 250'

TYPE OF WELL: Driven Date Constructed 1943

Depth drilled 26' Depth cased 26'

CASING RECORD:

4"

FINISH:

Perforations from 21' to 26'

AQUIFERS:

WATER LEVEL:

14'

PUMPING EQUIPMENT: Type F. M. 3" x 4" Cent.

H.P. 40

Capacity 500 G.P.M.

WELL TESTS:

Drawdown _____ ft. after _____ hours _____ G.P.M.

Drawdown _____ ft. after _____ hours _____ G.P.M.

USE OF WATER Irrigation Temp. _____ °F. _____, 19____

SOURCE OF INFORMATION GR Record

DRILLER or DIGGER _____

ADDITIONAL DATA:

Log N.A. Water Level Measurements _____ Chemical Analysis _____ Aquifer Test _____

REMARKS:

Irrigation of 30 acres.