

STATE ENGINEER
Salem, Oregon

Well Record *Berry*

STATE WELL NO. 14/5W-25F
COUNTY Benton
APPLICATION NO. GR-1472

GR- 1421 *6880*

OWNER: Harold & Elma Lister


MAILING ADDRESS: Rt. 3

LOCATION OF WELL: Owner's No. #2

CITY AND STATE: Junction City, Oregon

SE $\frac{1}{4}$ NW $\frac{1}{4}$ Sec. 25 T. 14 S., R. 5 W., W.M.

Bearing and distance from section or subdivision corner 775' N. & 1715' E. from W¹/₄ cor. Sec. 25

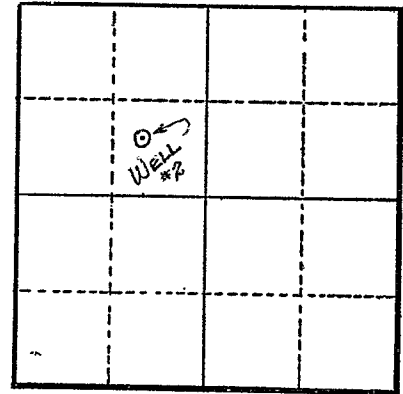

Section 25

Altitude at well 245'

TYPE OF WELL: Driven Date Constructed 1947

Depth drilled 25' Depth cased 25'

CASING RECORD:

2 - 4" steel casings interconnected 6' apart.

FINISH:

Perforated from 20' to 25'

AQUIFERS:

WATER LEVEL:

12'

PUMPING EQUIPMENT: Type F. M. 3" x 4" Cent. H.P. 40
Capacity 500 G.P.M.

WELL TESTS:

Drawdown ft. after hours G.P.M.

Drawdown ft. after hours G.P.M.

USE OF WATER Irrigation Temp. °F., 19.....

SOURCE OF INFORMATION GR Record

DRILLER or DIGGER

ADDITIONAL DATA:

Log N.A. Water Level Measurements Chemical Analysis Aquifer Test

REMARKS:

Irrigation of 30 acres.