

Well Record

STATE WELL NO. 14/5W-25H
COUNTY BENTON
APPLICATION NO. GR-2932

Bent
6881

OWNER: Jesse Fawver


MAILING ADDRESS: Rt. 3, Box 703

LOCATION OF WELL: Owner's No. _____

CITY AND STATE: Junction City, Oregon

SE 1/4 NE 1/4 Sec. 25 T. 14 N S., R. 5 E W., W.M.

Bearing and distance from section or subdivision corner 1200' 5° 30' W.

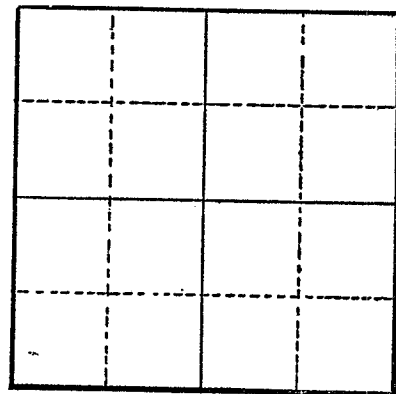

Section _____

Altitude at well _____

TYPE OF WELL: drilled Date Constructed 1946

Depth drilled 28 Depth cased 28

CASING RECORD:

4-inch

FINISH:

1/4" perforations 6" long; 2' of casing from 23 to 28

AQUIFERS:

WATER LEVEL:

16-feet

PUMPING EQUIPMENT: Type Fairbanks Morse Centrifugal H.P. 22
Capacity 700 G.P.M.

WELL TESTS:

Drawdown _____ ft. after _____ hours _____ G.P.M.
Drawdown _____ ft. after _____ hours _____ G.P.M.

USE OF WATER Irrigation Temp. _____ °F. _____, 19____

SOURCE OF INFORMATION GR-2758

DRILLER or DIGGER Jesse Fawver, Rt. 3, Box 703, Junction City, Oregon

ADDITIONAL DATA:

Log _____ Water Level Measurements _____ Chemical Analysis _____ Aquifer Test _____

REMARKS: