

STATE ENGINEER
Salem, Oregon

Well Record

STATE WELL NO. 14/5W-25J
COUNTY BENTON
APPLICATION NO. GR-2505

6882

OWNER: Rudolph Haffner

MAILING ADDRESS:

LOCATION OF WELL: Owner's No. #2


CITY AND STATE:

Junction City, Oregon

NE 1/4 SE 1/4 Sec. 25 T. 14 S., R. 5 W., W.M.

Bearing and distance from section or subdivision

corner S. 51° 47' W. 178.90'

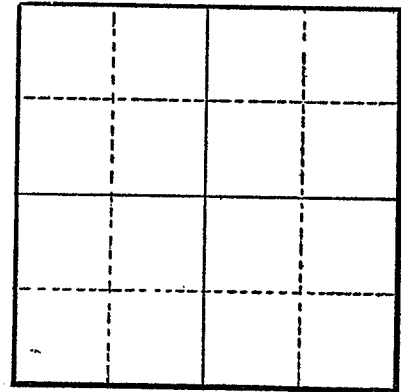

Section

Altitude at well

TYPE OF WELL: Drilled Date Constructed 1951

Depth drilled 26 Depth cased 26

CASING RECORD:

4-inch

FINISH:

Perforated pipe from 20' to 26'

AQUIFERS:

Loam, soil and gravel

WATER LEVEL:

10-feet

PUMPING EQUIPMENT: Type Fairbanks Morse Centrifugal H.P. 25
Capacity 450 G.P.M.

WELL TESTS:

Drawdown 5 ft. after hours Pumping 450 G.P.M.

Drawdown ft. after hours G.P.M.

USE OF WATER Irrigation Temp. °F., 19

SOURCE OF INFORMATION GR-2372

DRILLER or DIGGER

ADDITIONAL DATA:

Log Water Level Measurements Chemical Analysis Aquifer Test

REMARKS:

Sandy loam soil on top	10	16
River wash gravel	16	26