

STATE ENGINEER  
Salem, Oregon

# Well Record

STATE WELL NO. 14/5W-25J  
COUNTY BENTON  
APPLICATION NO. GR-2506

6883

OWNER: Rudolph Haffner


MAILING ADDRESS: \_\_\_\_\_

LOCATION OF WELL: Owner's No. #1

CITY AND STATE: Junction City, Oregon

NE  $\frac{1}{4}$  SE  $\frac{1}{4}$  Sec. 25 T. 14 N S., R. 5 E W., W.M.

Bearing and distance from section or subdivision corner S. 54° 27' W. 1340.14'

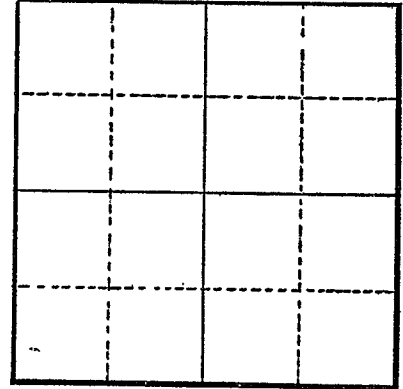

Section \_\_\_\_\_

Altitude at well \_\_\_\_\_

TYPE OF WELL: Drilled Date Constructed 1952

Depth drilled 26 Depth cased 26

CASING RECORD:

10-inch

FINISH:

Perforated 10" casing from 23' to 26'

AQUIFERS:

Clay, loam and gravel

WATER LEVEL:

10-feet

PUMPING EQUIPMENT: Type Fairbanks Morse H.P. 20  
Capacity 500 G.P.M.

WELL TESTS:

Drawdown 4 ft. after \_\_\_\_\_ hours Pumping 480 G.P.M.

Drawdown \_\_\_\_\_ ft. after \_\_\_\_\_ hours \_\_\_\_\_ G.P.M.

USE OF WATER Irrigation Temp. \_\_\_\_\_ °F., 19

SOURCE OF INFORMATION GR-2373

DRILLER or DIGGER \_\_\_\_\_

ADDITIONAL DATA:

Log X Water Level Measurements \_\_\_\_\_ Chemical Analysis \_\_\_\_\_ Aquifer Test \_\_\_\_\_

REMARKS:

Silty clay loam 10 26  
River wash gravel 16 26