

STATE ENGINEER
Salem, Oregon

Well Record *Bert*

STATE WELL NO. 14/5W-250
COUNTY Benton
APPLICATION NO. GR-2081

6884

OWNER: Edward Dempsay


MAILING ADDRESS: Route 2

LOCATION OF WELL: Owner's No. _____

CITY AND STATE: Eugene, Oregon

SW $\frac{1}{4}$ SE $\frac{1}{4}$ Sec. 25 T. 14 S., R. 5 W., W.M.

Bearing and distance from section or subdivision corner 1481 chs E & 1397 chs N of SE corner of SW of Section 25

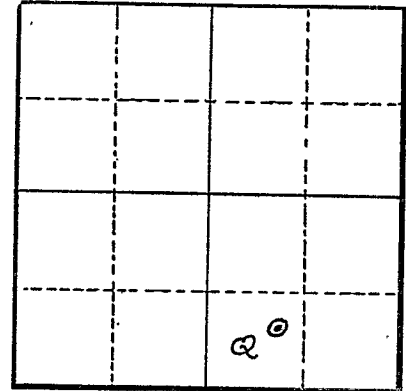

Section 25

Altitude at well _____

TYPE OF WELL: Driven Date Constructed 1950

Depth drilled 19' Depth cased 19'

CASING RECORD:

4-inch

FINISH:

slots 16' to 19'

AQUIFERS:

sand gravel

WATER LEVEL:

8'

PUMPING EQUIPMENT: Type Centrifugal

Capacity _____ G.P.M. H.P. _____

WELL TESTS:

Drawdown _____ ft. after _____ hours _____ G.P.M.

Drawdown _____ ft. after _____ hours _____ G.P.M.

USE OF WATER Irrigation Temp. _____ °F., 19____

SOURCE OF INFORMATION GR-3846

DRILLER or DIGGER Owner

ADDITIONAL DATA:

Log Water Level Measurements _____ Chemical Analysis _____ Aquifer Test _____

REMARKS:

sand gravel