

STATE ENGINEER
Salem, Oregon

Well Record

*Bent
6895*


STATE WELL NO. 14/5W-26R
COUNTY Benton
APPLICATION NO. GR-4116

OWNER: Martin C. Goracke MAILING ADDRESS: Route 3

LOCATION OF WELL: Owner's No. _____ CITY AND STATE: Junction City, Oregon

SE 1/4 SE 1/4 Sec. 26 T. 14 S., R. 5 W., W.M.

Bearing and distance from section or subdivision corner 1240' N. 67° W. from common Cor. Secs. 25, 26, 35, 36

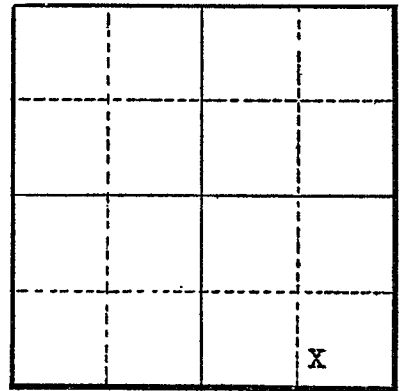

Section 26

Altitude at well _____

TYPE OF WELL: Dug Date Constructed 1941

Depth drilled 15 ft. Depth cased 15 ft.

CASING RECORD:

wood cased 4 x 4 from 0 to 15 feet

FINISH:

AQUIFERS:

WATER LEVEL:

7 feet below surface

PUMPING EQUIPMENT: Type 5 x 4 centrifugal H.P. 40
Capacity 700 G.P.M.

WELL TESTS:

Drawdown 6 ft. after _____ hours 700 G.P.M.
Drawdown _____ ft. after _____ hours _____ G.P.M.

USE OF WATER Irrigation Temp. _____ °F., 19 _____

SOURCE OF INFORMATION Well Registration Statement Cert. # GR-3699

DRILLER or DIGGER _____

ADDITIONAL DATA:

Log _____ Water Level Measurements _____ Chemical Analysis _____ Aquifer Test _____

REMARKS: