

STATE ENGINEER  
Salem, Oregon

# Well Record

STATE WELL NO. 14/5W-27C(1)  
COUNTY Benton  
APPLICATION NO. GR-558

OWNER: C. M. Hubbard & Son


MAILING ADDRESS: \_\_\_\_\_

LOCATION OF WELL: Owner's No. #2

CITY AND STATE: Junction City, Oregon

NE 1/4 NW 1/4 Sec. 27 T. 14 S., R. 5 W., W.M.

Bearing and distance from section or subdivision corner \_\_\_\_\_

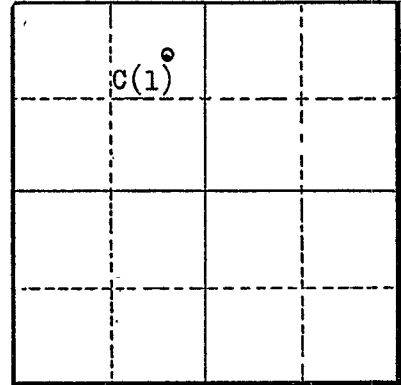

Section 27

Altitude at well \_\_\_\_\_

TYPE OF WELL: Drilled Date Constructed 6/17/50

Depth drilled 34' Depth cased \_\_\_\_\_

CASING RECORD:

12-inch

FINISH:

AQUIFERS:

WATER LEVEL:

28' (Est.)

PUMPING EQUIPMENT: Type Fairbanks Morse H.P. 20  
Capacity \_\_\_\_\_ G.P.M.

WELL TESTS:

Drawdown \_\_\_\_\_ ft. after \_\_\_\_\_ hours \_\_\_\_\_ G.P.M.  
Drawdown \_\_\_\_\_ ft. after \_\_\_\_\_ hours \_\_\_\_\_ G.P.M.

USE OF WATER Irrigation 80 acres Temp. \_\_\_\_\_ °F. \_\_\_\_\_, 19\_\_\_\_

SOURCE OF INFORMATION GR-558

DRILLER or DIGGER Frank Skillings, Corvallis, Oregon

ADDITIONAL DATA:

Log \_\_\_\_\_ Water Level Measurements \_\_\_\_\_ Chemical Analysis \_\_\_\_\_ Aquifer Test \_\_\_\_\_

REMARKS:

Surface soil, chehalis; followed by 30' of sandy soil; folled by 3 to 4 feet of gravel and coble stones.