

STATE ENGINEER  
Salem, Oregon

# Well Record

*Bent*  
*6900*

STATE WELL NO. 14/5W-27R(1)  
COUNTY Benton  
APPLICATION NO. GR-557

OWNER: C. M. Hubbard & Son


MAILING ADDRESS: .....

LOCATION OF WELL: Owner's No. #1

CITY AND STATE: Junction City, Oregon

SE 1/4 SE 1/4 Sec. 27 T. 14 S., R. 5 W., W.M.

Bearing and distance from section or subdivision corner .....

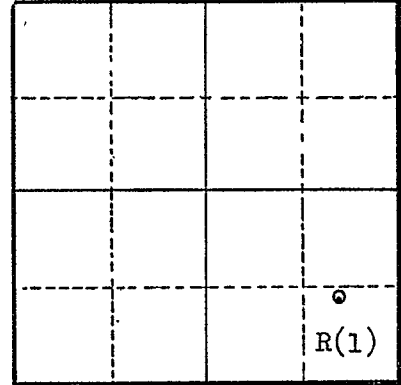

Altitude at well 288' Interpolated

TYPE OF WELL: Driven Date Constructed 9/29/52

Depth drilled 22' Depth cased 22'

Section 27

### CASING RECORD:

4-inch

### FINISH:

### AQUIFERS:

### WATER LEVEL:

10 to 11 feet

PUMPING EQUIPMENT: Type Fairbanks Morse centrifugal H.P. 20  
Capacity 400-500 G.P.M.

### WELL TESTS:

Drawdown ..... ft. after ..... hours ..... G.P.M.  
Drawdown ..... ft. after ..... hours ..... G.P.M.

USE OF WATER Irrigation 60 acres Temp. ..... °F. ...., 19.....

SOURCE OF INFORMATION GR-557

DRILLER or DIGGER H. O. Paeschke, Junction City, Oregon

### ADDITIONAL DATA:

Log ..... Water Level Measurements ..... Chemical Analysis ..... Aquifer Test .....

### REMARKS: