

STATE ENGINEER
Salem, Oregon


Well Record

Bent
6000

STATE WELL NO. 14/5W-30E
COUNTY Benton
APPLICATION NO. GR-4099

OWNER: John L. Shook MAILING ADDRESS: Route 3
CITY AND STATE: Junction City, Oregon

LOCATION OF WELL: Owner's No. _____
SW 1/4 NW 1/4 Sec. 30 T. 14 S., R. 5 W., W.M.
Bearing and distance from section or subdivision
corner 15' E., 329' S. to SE Cor. lot 25, Sec. 30

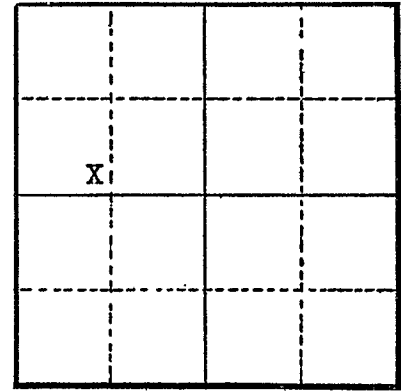

Section 30

Altitude at well _____

TYPE OF WELL: Driven Date Constructed 1945
Depth drilled 21 ft. Depth cased 21 ft.

CASING RECORD:

4 inch steel casing set to 21 feet

FINISH:

slotted size and number unknown perforations from 16 to 21 feet

AQUIFERS:

WATER LEVEL:

12 feet below surface

PUMPING EQUIPMENT: Type Fairbanks Morse centrifugal 2 1/2 x 2 H.P. 24
Capacity 250 G.P.M.

WELL TESTS:

Drawdown _____ ft. after _____ hours _____ G.P.M.
Drawdown _____ ft. after _____ hours _____ G.P.M.

USE OF WATER Irrigation Temp. _____ °F., 19____

SOURCE OF INFORMATION Well Registration Statement Cert. # GR-3688

DRILLER or DIGGER _____

ADDITIONAL DATA:

Log _____ Water Level Measurements _____ Chemical Analysis _____ Aquifer Test _____

REMARKS: