

STATE ENGINEER
Salem, Oregon

Well Record

Bent STATE WELL NO. 14/5W-34E(1)
7107 COUNTY Benton
APPLICATION NO. GR-29

OWNER: Freeman Edwin Graville


MAILING ADDRESS: Route 3, Box 359

LOCATION OF WELL: Owner's No. #1

CITY AND STATE: Junction City, Oregon

SW 1/4 NW 1/4 Sec. 34 T. 14 S., R. 5 E. W., W.M.

Bearing and distance from section or subdivision
corner 26 chains south and 6.2 chains east of NW
corner of Section 34

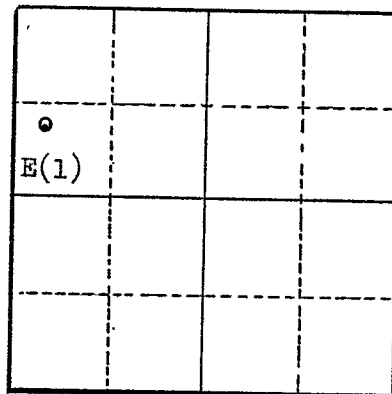

Section 34

Altitude at well 295' Interpolated

TYPE OF WELL: Driven Date Constructed May 1951

Depth drilled 28' Depth cased _____

CASING RECORD:

4-inch pipe driven to 28 feet.

FINISH:

None

AQUIFERS:

WATER LEVEL:

20 feet (Summer) 10 feet (Spring) below land surface

PUMPING EQUIPMENT: Type Jacuzzi 3" x 4" H.P. 7 1/2
Capacity 290 G.P.M.

WELL TESTS:

Drawdown _____ ft. after _____ hours _____ G.P.M.

Drawdown _____ ft. after _____ hours _____ G.P.M.

USE OF WATER Irrigation 15.6 acres Temp. _____ °F., 19 _____

SOURCE OF INFORMATION Registration Statement GR-29

DRILLER or DIGGER _____

ADDITIONAL DATA:

Log No Water Level Measurements _____ Chemical Analysis _____ Aquifer Test _____

REMARKS: