

STATE ENGINEER
Salem, Oregon

Well Record

7158 Bent
STATE WELL NO. 14/5W-34R
COUNTY BENTON
APPLICATION NO. GR-2774

OWNER: Ray H Roach & Eileen L Roach


MAILING
ADDRESS: Rt 3 Box 525

LOCATION OF WELL: Owner's No.

CITY AND
STATE: Junction City, Oregon

SE $\frac{1}{4}$ SE $\frac{1}{4}$ Sec. 34 T. 14 S. R. 5 W., W.M.

Bearing and distance from section or subdivision
corner 1200' W & 720' S from SE corner Section 34

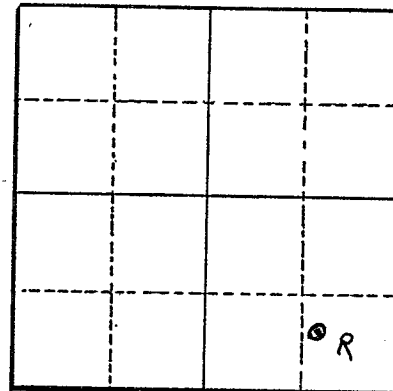

Section 34

Altitude at well

TYPE OF WELL: Drilled Date Constructed 1954

Depth drilled 21' Depth cased 21'

CASING RECORD:

2-inch

FINISH:

Perforated Casing -(3') $\frac{1}{2}$ " X $1\frac{1}{2}$ " Perf. 20 cour

AQUIFERS:

Dirt, Gravel

WATER LEVEL:

10'

PUMPING EQUIPMENT: Type Homart, centrifugal 2"

H.P. 4

Capacity 95 G.P.M.

WELL TESTS:

Drawdown 5 ft. after hours 60 G.P.M.

Drawdown ft. after hours G.P.M.

USE OF WATER Irrigation

Temp. °F. 19

SOURCE OF INFORMATION GR-3854

DRILLER or DIGGER NA

ADDITIONAL DATA:

Log X Water Level Measurements Chemical Analysis Aquifer Test

REMARKS:

Dirt a out 8', then Gravel