

STATE ENGINEER
Salem, Oregon

Well Record

Bent
7009

STATE WELL NO. 14/5M-34R
COUNTY Benton
APPLICATION NO. GR-2508

OWNER: Neil Sherman

MAILING
ADDRESS: Rt. 3

LOCATION OF WELL: Owner's No.

CITY AND
STATE: Junction City, Oregon

SE 1/4 SE 1/4 Sec. 34 T. 14 S. R. 5 W., W.M.


Bearing and distance from section or subdivision

corner 1/4 mile NW of S exit corner of Sec. 34

Altitude at well

TYPE OF WELL: Drilled Date Constructed 1954

Depth drilled 34' Depth cased 34'

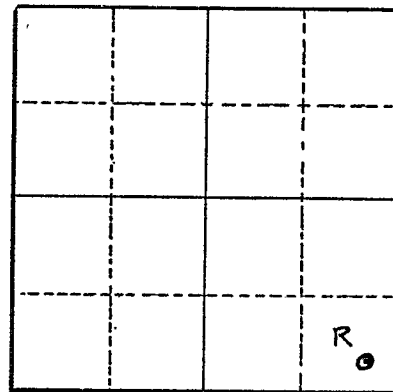

Section 34

CASING RECORD:

4-inch

FINISH:

5/8" holes 25 or 30 holes

31' to 34'

AQUIFERS: Top dirt
Clay
Gravel

WATER LEVEL:

4'

PUMPING EQUIPMENT: Type Homart Impeller
Capacity 175 G.P.M.

H.P. 4

WELL TESTS:

Drawdown ft. after hours G.P.M.

Drawdown ft. after hours G.P.M.

USE OF WATER Irrigation Temp. °F. 19

SOURCE OF INFORMATION GR-3841

DRILLER or DIGGER NA

ADDITIONAL DATA:

Log X Water Level Measurements Chemical Analysis Aquifer Test

REMARKS:

Top dirt 4' to 30'
Clay 10' to 20'
Gravel 20' to 20'