

STATE ENGINEER  
Salem, Oregon


Well Record *Bent* STATE WELL NO. 14/5W-350  
COUNTY Benton  
*7119* APPLICATION NO. GR-4271

OWNER: J. Chester Oakes MAILING ADDRESS: Box 175

LOCATION OF WELL: Owner's No. \_\_\_\_\_ CITY AND STATE: Monroe, Oregon

NE  $\frac{1}{4}$  NW  $\frac{1}{4}$  Sec. 35 T. 14 N. S., R. 5 E. W., W.M.

Bearing and distance from section or subdivision  
corner 1385.0 feet East and 756.0 feet South of  
the SW Corner Wm. Coyle DLC

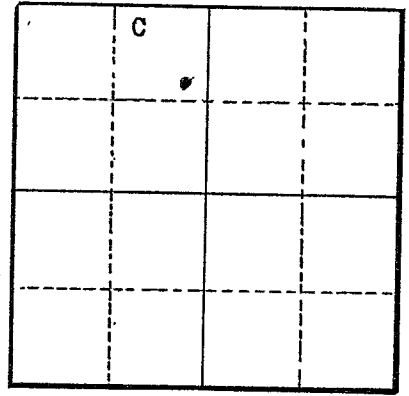

Altitude at well 200 feet

TYPE OF WELL: Driven Date Constructed June 1952

Depth drilled 27 1/2 feet Depth cased 27 1/2 feet

Section 35

CASING RECORD:  
4-inch pipe from 0 to 27 1/2 feet

FINISH:

AQUIFERS:  
sand and gravel

WATER LEVEL:  
17 feet

PUMPING EQUIPMENT: Type Montgomery Ward 4" H.P. \_\_\_\_\_  
Capacity 240 G.P.M.

WELL TESTS:  
Drawdown \_\_\_\_\_ ft. after \_\_\_\_\_ hours 240 G.P.M.  
Drawdown \_\_\_\_\_ ft. after \_\_\_\_\_ hours \_\_\_\_\_ G.P.M.

USE OF WATER Irrigation Temp. \_\_\_\_\_ °F. \_\_\_\_\_, 19\_\_\_\_

SOURCE OF INFORMATION GR-4122

DRILLER or DIGGER Frank Hollaway

ADDITIONAL DATA:  
Log x Water Level Measurements \_\_\_\_\_ Chemical Analysis \_\_\_\_\_ Aquifer Test \_\_\_\_\_

REMARKS:  
sand and gravel 27 1/2 feet