

STATE ENGINEER
Salem, Oregon

Well Record

Bent
7121

STATE WELL NO. 14/5W-35H
COUNTY BENTON
APPLICATION NO. GR-2509

OWNER: Merle Hewitt

MAILING
ADDRESS: Rt. 1, Box 119


LOCATION OF WELL: Owner's No.

CITY AND
STATE: Monroe, Oregon

SE 1/4 NE 1/4 Sec. 35 T. 14 N. S., R. 5 E. W., W.M.

Bearing and distance from section or subdivision

corner N. 42° 50' E. 1065'

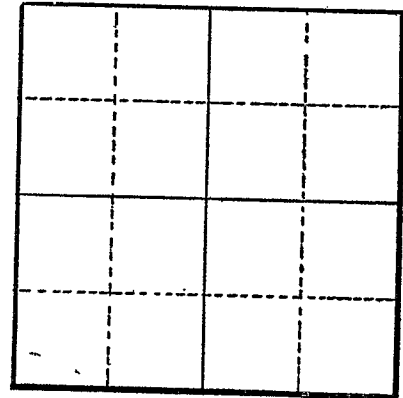

Section

Altitude at well

TYPE OF WELL: Drilled Date Constructed 1955

Depth drilled 23 Depth cased 23

CASING RECORD:

6-inch

FINISH:

Slotted from 15 to 23

AQUIFERS:

WATER LEVEL:

6-feet

PUMPING EQUIPMENT: Type Centrifugal Capacity 400 G.P.M. H.P. 25

WELL TESTS:

Drawdown 2 ft. after hours Pumping 350 G.P.M.

Drawdown ft. after hours G.P.M.

USE OF WATER Irrigation Temp. °F. 19

SOURCE OF INFORMATION GR-2376

DRILLER or DIGGER Oran Nye, Monroe, Oregon

ADDITIONAL DATA:

Log Water Level Measurements Chemical Analysis Aquifer Test

REMARKS: