

STATE ENGINEER
Salem, Oregon

Well Record

STATE WELL NO. 14/5W-36E
COUNTY Benton
APPLICATION NO. GR-3020

OWNER: Roy H. Hewitt

MAILING

ADDRESS: 2980 West 18th

LOCATION OF WELL: Owner's No. _____


CITY AND

STATE: Eugene, Oregon

SW 1/4 NW 1/4 Sec. 36 T. 14 S., R. 5 W., W.M.

Bearing and distance from section or subdivision

corner S. 32° 15' E., 985' from NW Corner, said
corner being 10.71 chains S. 0° 31' W. of
the NW Corner of Sec. 36

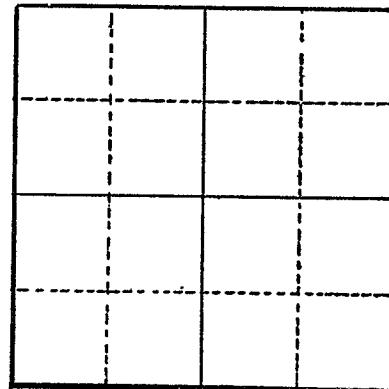

Altitude at well _____

TYPE OF WELL: drilled Date Constructed 1953

Depth drilled 23' Depth cased 23'

Section _____

CASING RECORD:

8 inches

FINISH:

Perforated, size and number unknown, from 20 to 23

AQUIFERS:

WATER LEVEL:

12 feet

PUMPING EQUIPMENT: Type Fairbanks Morse Centrifugal

H.P. 25

Capacity 300 G.P.M.

WELL TESTS:

Drawdown 2 ft. after _____ hours pumping 300 G.P.M.

Drawdown _____ ft. after _____ hours _____ G.P.M.

USE OF WATER Irrigation

Temp. _____ °F., 19

SOURCE OF INFORMATION GR- 2827

DRILLER or DIGGER Walter Nelson, Junction City, Oregon

ADDITIONAL DATA:

Log _____ Water Level Measurements _____ Chemical Analysis _____ Aquifer Test _____

REMARKS: