


OWNER: H. G. McElroy (Atracia Ranch) MAILING ADDRESS: Star Route

LOCATION OF WELL: Owner's No. _____ CITY AND STATE: Alsea, Oregon

NE $\frac{1}{4}$ SW $\frac{1}{4}$ Sec. 8 T. 14 S., R. 8 W., W.M.

Bearing and distance from section or subdivision corner 32.5 ch. N. & 28 ch. E. from SW Cor. Sec. 8

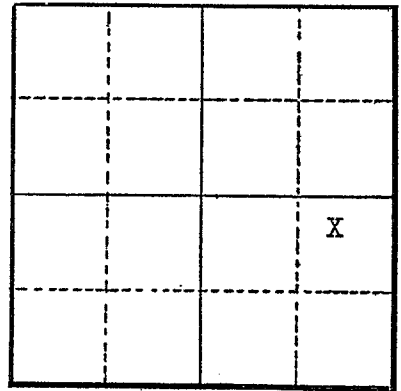

Section 8

Altitude at well _____

TYPE OF WELL: Dug Date Constructed 1955

Depth drilled 42 ? Depth cased _____

CASING RECORD:

FINISH:

AQUIFERS:

WATER LEVEL:

4 feet below surface

PUMPING EQUIPMENT: Type Briggs Stratton H.P. 1 1/2
Capacity 30 G.P.M.

WELL TESTS:

Drawdown 4" ft. after _____ hours 40 G.P.M.
Drawdown _____ ft. after _____ hours _____ G.P.M.

USE OF WATER Irrigation Temp. _____ °F., 19 _____

SOURCE OF INFORMATION Well Registration Statement

DRILLER or DIGGER _____

ADDITIONAL DATA:

Log _____ Water Level Measurements _____ Chemical Analysis _____ Aquifer Test _____

REMARKS: