

STATE ENGINEER
Salem, Oregon

Well Record

Bent STATE WELL NO. 15/4W-5N
COUNTY Benton
7606 APPLICATION NO. GR-3549

OWNER: Clyde R. Morgan


MAILING ADDRESS: Route 3

LOCATION OF WELL: Owner's No. _____

CITY AND STATE: Junction City, Oregon

SW 1/4 SW 1/4 Sec. 5 T. 15 S., R. 4 W., W.M.

Bearing and distance from section or subdivision corner 1160 ft. N. and 2 ft. E. from the SW corner Sec. 5

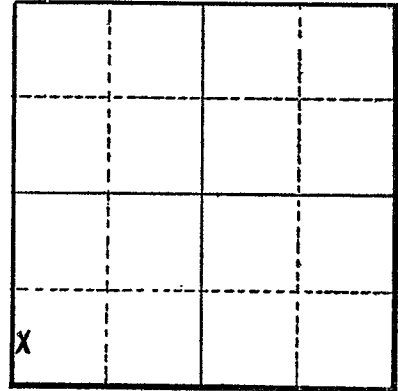

Section 5

Altitude at well _____

TYPE OF WELL: Driven Date Constructed May, 1951

Depth drilled 21 ft. Depth cased _____

CASING RECORD:

4 inch diameter casing depth unknown

FINISH:

AQUIFERS:

Gravel

WATER LEVEL:

PUMPING EQUIPMENT: Type Berkley 2 1/2" electric _____ H.P. 15
Capacity 350 G.P.M.

WELL TESTS:

Drawdown _____ ft. after _____ hours _____ G.P.M.

Drawdown _____ ft. after _____ hours _____ G.P.M.

USE OF WATER Irrigation Temp. _____ °F. _____, 19____

SOURCE OF INFORMATION Well Registration Statement

DRILLER or DIGGER _____

ADDITIONAL DATA:

Log X Water Level Measurements _____ Chemical Analysis _____ Aquifer Test _____

REMARKS:

Log:
Gravel