

STATE ENGINEER
Salem, Oregon

Well Record

STATE WELL NO. 15/4W-6F
COUNTY Benton
APPLICATION NO. GR-1306

GR- 1263

MAILING
ADDRESS:

OWNER: Jesse Harper

CITY AND


LOCATION OF WELL: Owner's No. #4

STATE: Junction City, Oregon

SE $\frac{1}{4}$ NW $\frac{1}{4}$ Sec. 6 T. 15 S. R. 4 W., W.M.

Bearing and distance from section or subdivision

corner 681' N. & 3263' W. from W $\frac{1}{4}$ cor. Sec. 5.

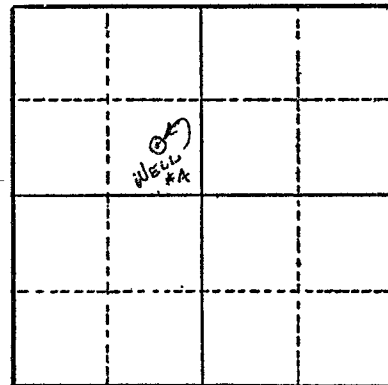

Section 6

Altitude at well 300 ft.

TYPE OF WELL: Driven Date Constructed 1950

Depth drilled 25 ft. Depth cased 24 ft.

CASING RECORD:

4 inch

FINISH:

Perforated from 21 to 24 ft.

AQUIFERS:

WATER LEVEL:

12 ft.

PUMPING EQUIPMENT: Type Cent. H.P. 15
Capacity 350 G.P.M.

WELL TESTS:

Drawdown _____ ft. after _____ hours _____ G.P.M.

Drawdown _____ ft. after _____ hours _____ G.P.M.

USE OF WATER Irrigation Temp. _____ °F. _____, 19

SOURCE OF INFORMATION G. R. Record

DRILLER or DIGGER _____

ADDITIONAL DATA:

Log N.A. Water Level Measurements _____ Chemical Analysis _____ Aquifer Test _____

REMARKS:

Irrigation of 40 acres.