

STATE ENGINEER
Salem, Oregon

Well Record *Bent*


STATE WELL NO. 15/4W-6H
COUNTY BENTON
APPLICATION NO. GR-2713

OWNER: Leonard J. Freeman MAILING ADDRESS: Route 3

LOCATION OF WELL: Owner's No. #2 CITY AND STATE: Junction City, Oregon

SE 1/4 NE 1/4 Sec. 6 T. 15 S., R. 4 W., W.M.

Bearing and distance from section or subdivision corner S. 308.94' hence E. 850.55'

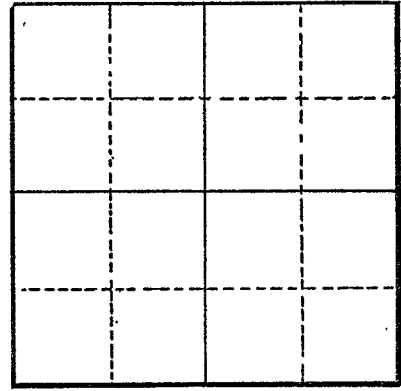

Section _____

Altitude at well _____

TYPE OF WELL: driven Date Constructed 1950

Depth drilled 21 Depth cased 21

CASING RECORD:

4-inch

FINISH:

size and number of perforations unknown from 17 to 21

AQUIFERS:

WATER LEVEL:

12-feet

PUMPING EQUIPMENT: Type Berkeley Centrifugal H.P. 15
Capacity 400 G.P.M.

WELL TESTS:

Drawdown _____ ft. after _____ hours Pumping 400 G.P.M.
Drawdown _____ ft. after _____ hours _____ G.P.M.

USE OF WATER irrigation Temp. _____ °F. _____, 19____

SOURCE OF INFORMATION GR-2566

DRILLER or DIGGER

ADDITIONAL DATA:

Log _____ Water Level Measurements _____ Chemical Analysis _____ Aquifer Test _____

REMARKS: