

STATE ENGINEER
Salem, Oregon

Well Record

Bent
7610

STATE WELL NO. 15/4W-6H
COUNTY BENTON
APPLICATION NO. GR-2712

OWNER: Leonard J. Freeman


MAILING ADDRESS: Route 3

LOCATION OF WELL: Owner's No. #1

CITY AND STATE: Junction City, Oregon

SE 1/4 NE 1/4 Sec. 6 T. 15 S. R. 4 W., W.M.

Bearing and distance from section or subdivision corner E. 847.91' hence S. 1054.66'

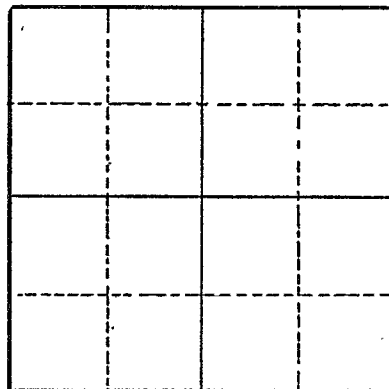

Section

Altitude at well

TYPE OF WELL: driven Date Constructed 1942

Depth drilled 21 Depth cased 21

CASING RECORD:

4-inch

FINISH:

Size and number of perforations unknown from 17 to 21

AQUIFERS:

Sand and gravels

WATER LEVEL:

12-feet

PUMPING EQUIPMENT: Type Fairbanks Morse Centrifugal H.P. 25
Capacity 400 G.P.M.

WELL TESTS:

Drawdown ft. after hours Pumping 400 G.P.M.
Drawdown ft. after hours G.P.M.

USE OF WATER irrigation Temp. °F. 19

SOURCE OF INFORMATION GR-2565

DRILLER or DIGGER

ADDITIONAL DATA:

Log Water Level Measurements Chemical Analysis Aquifer Test

REMARKS:

Sand and gravels