

STATE ENGINEER
Salem, Oregon

Well Record

Bent
7616

STATE WELL NO. 15/4W-6A
COUNTY BENTON
APPLICATION NO. GR-2714

OWNER: Leonard J. Freeman

MAILING

ADDRESS: Route 3

LOCATION OF WELL: Owner's No. #3

CITY AND

STATE: Junction City, Oregon

NE 1/4 NE 1/4 Sec. 6 T. 15 S. R. 4 W., W.M.


Bearing and distance from section or subdivision

corner N. 507.64' hence E. 481.12'

Altitude at well

TYPE OF WELL: driven Date Constructed 1952

Depth drilled 21 Depth cased 21

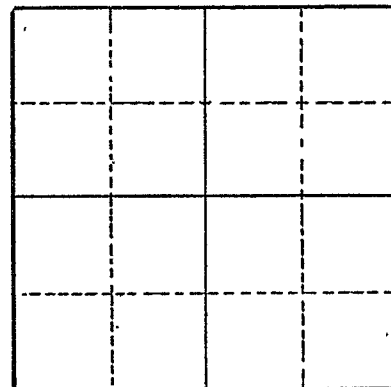

Section

CASING RECORD:

3-inch

FINISH:

size and number of perforations unknown

AQUIFERS:

WATER LEVEL:

12-feet

PUMPING EQUIPMENT: Type Fairbanks Morse Centrifugal H.P. 25
Capacity 400 G.P.M.

WELL TESTS:

Drawdown ft. after hours Pumping 350 G.P.M.
Drawdown ft. after hours G.P.M.

USE OF WATER irrigation Temp. °F., 19

SOURCE OF INFORMATION GR-2567

DRILLER or DIGGER

ADDITIONAL DATA:

Log Water Level Measurements Chemical Analysis Aquifer Test

REMARKS: