

STATE ENGINEER  
Salem, Oregon

# Well Record

*Bent  
7618*

STATE WELL NO. 15/4W - 6J  
COUNTY BENTON  
APPLICATION NO. GR-2137


OWNER: L. W. Forcht

MAILING ADDRESS: Rt. 3, Box 765

LOCATION OF WELL: Owner's No. #3  
NE 1/4 SE 1/4 Sec. 6 T. 15 N. S., R. 4 W., W.M.

CITY AND STATE: Junction City, Oregon

Bearing and distance from section or subdivision corner 1319.74' S. and 728.92' W.

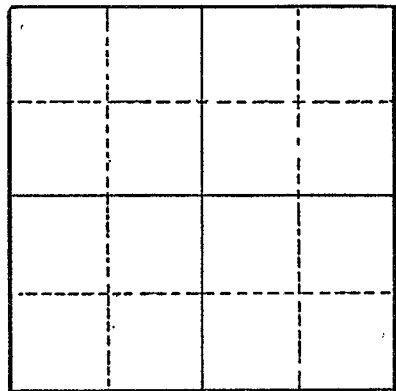

Section .....

Altitude at well .....

TYPE OF WELL: Driven Date Constructed 1947

Depth drilled 21 Depth cased .....

CASING RECORD:

2 - 4-Inch

FINISH:

3' Perforated points

AQUIFERS:

WATER LEVEL:

12-feet

PUMPING EQUIPMENT: Type Fairbanks H.P. 20  
Capacity 450 G.P.M.

WELL TESTS:

Drawdown ..... ft. after ..... hours ..... G.P.M.  
Drawdown ..... ft. after ..... hours ..... G.P.M.

USE OF WATER Irrigation Temp. ..... °F. ...., 19.....

SOURCE OF INFORMATION GR-2050

DRILLER or DIGGER Walter Nelson, Junction City, Oregon

ADDITIONAL DATA:

Log ..... Water Level Measurements ..... Chemical Analysis ..... Aquifer Test .....

REMARKS: