

STATE ENGINEER
Salem, Oregon

Well Record

Bent
7638
STATE WELL NO. 15/5W-1E
COUNTY Benton
APPLICATION NO. G-1728

OWNER: Harry O. Hansen

MAILING

ADDRESS: Rt. 3

LOCATION OF WELL: Owner's No. _____


CITY AND

STATE: Junction City, Oregon

SW 1/4 NW 1/4 Sec. 1 T. 15 S., R. 5 W., W.M.

Bearing and distance from section or subdivision

corner 700' N. & 500' W. of center of
section 1.

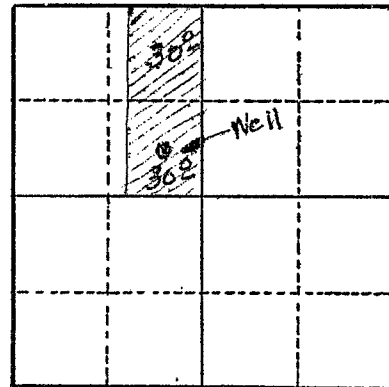

Section 1

Altitude at well 260 ft.

TYPE OF WELL: Driven Date Constructed 1944

Depth drilled 22 ft. Depth cased 22 ft.

CASING RECORD:

4 inch

FINISH:

1/4" x 2" slits from 17' to 22'

AQUIFERS:

WATER LEVEL:

7 ft/

PUMPING EQUIPMENT: Type Berkeley combination cent. H.P. 10
Capacity 300 G.P.M.

WELL TESTS:

Drawdown 1 ft. after _____ hours 350 G.P.M.

Drawdown _____ ft. after _____ hours _____ G.P.M.

USE OF WATER Irrigation Temp. _____ °F., 19 _____

SOURCE OF INFORMATION Related registration statement

DRILLER or DIGGER _____

ADDITIONAL DATA:

Log _____ Water Level Measurements _____ Chemical Analysis _____ Aquifer Test _____

REMARKS:

Log: Chehalis 0' to 6'
Loose gravel 6' to 14'
Big boulder 14' to 22'