

STATE ENGINEER
Salem, Oregon

Well Record

Bent
7659
STATE WELL NO. 15/5W-2F
COUNTY Benton
APPLICATION NO. GR-3880

OWNER: Walter P. Hubbard

MAILING

ADDRESS: Junction City,

CITY AND


STATE: Oregon

LOCATION OF WELL: Owner's No.

SE $\frac{1}{4}$ NW $\frac{1}{4}$ Sec. 2 T. 15 S. R. 5 E. W.M.

Bearing and distance from section or subdivision

corner 2130' S. & 1875' E. of NW Cor. Sec. 2

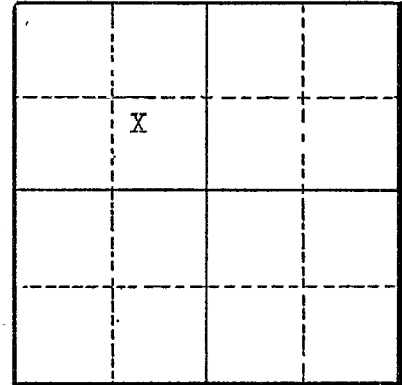

Section 2

Altitude at well

TYPE OF WELL: Drilled Date Constructed 1944

Depth drilled 47 feet Depth cased 47 feet

CASING RECORD:

8 inch casing set to 47 feet

FINISH:

drilled holes from 42 to 47 feet

AQUIFERS:

WATER LEVEL:

8 to 16 feet below surface

PUMPING EQUIPMENT: Type Fairbanks Morse

H.P. 5

Capacity 250 G.P.M.

WELL TESTS:

Drawdown 8 ft. after 90 hours G.P.M.

Drawdown ft. after hours G.P.M.

USE OF WATER Irrigation Temp. °F. 19

SOURCE OF INFORMATION Well Registration Statement Cert. # GR-3529

DRILLER or DIGGER

ADDITIONAL DATA:

Log Water Level Measurements Chemical Analysis Aquifer Test

REMARKS: