

STATE OF OREGON
WATER WELL REPORT
(as required by ORS 537.765)

BENT 094
OCT 94
-4 1990

WATER RESOURCES DEPT. (START CARD) #
SALEM, OREGON

115/5W/29

21054

(1) OWNER:

Name Laurence Labron Well Number: _____
Address 4173 N.W. Peppertree Pl.
City Cornwall State Oreg. Zip 97330

(2) TYPE OF WORK:

☒ New Well ☐ Deepen ☐ Recondition ☐ Abandon

(3) DRILL METHOD

☒ Rotary Air ☐ Rotary Mud ☐ Cable
☐ Other _____

(4) PROPOSED USE:

☒ Domestic ☐ Community ☐ Industrial ☐ Irrigation
☐ Thermal ☐ Injection ☐ Other _____

(5) BORE HOLE CONSTRUCTION:

Special Construction approval Yes No Depth of Completed Well 290 ft.
Explosives used ☐ Yes ☐ No Type _____ Amount _____

HOLE			SEAL			Amount sacks or pounds
Diameter	From	To	Material	From	To	
10"	0	39	Cement	0	39	10
6"	39	290				

How was seal placed: Method ☐ A ☐ B ☒ C ☐ D ☐ E

☐ Other _____

Backfill placed from _____ ft. to _____ ft. Material _____

Gravel placed from _____ ft. to _____ ft. Size of gravel _____

(6) CASING/LINER:

	Diameter	From	To	Gauge	Steel	Plastic	Welded	Threaded
Casing:	6"	0	39	250	☒	☐	☐	☐
Liner:					☐	☐	☐	☐

Final location of shoe(s) _____

(7) PERFORATIONS/SCREENS:

☐ Perforations

Method _____

☐ Screens

Type _____

Material _____

From	To	Slot size	Number	Diameter	Tele/pipe size	Casing	Liner
						☐	☐
						☐	☐
						☐	☐
						☐	☐
						☐	☐
						☐	☐

(8) WELL TESTS: Minimum testing time is 1 hour

☐ Pump

☐ Bailer

☒ Air

☐ Flowing
☐ Artesian

Yield gal/min

Drawdown

Drill stem at

Time

30 247 289 1 hr.

Temperature of water 52 Depth Artesian Flow Found _____

Was a water analysis done? ☐ Yes By whom _____

Did any strata contain water not suitable for intended use? ☐ Too little

☐ Salty ☐ Muddy ☐ Odor ☐ Colored ☐ Other _____

Depth of strata: _____

(9) LOCATION OF WELL by legal description:

County Benton Latitude _____ Longitude _____
Township 11 N or S Range 5 E or W, WM.
Section 24 1/4 1/4
Tax Lot _____ Lot _____ Block _____ Subdivision _____
Street Address of Well (or nearest address) Grandview DR.
Cornwall, Oreg. 97330

(10) STATIC WATER LEVEL:

42 ft. below land surface. Date 9-27-90
Artesian pressure _____ lb. per square inch. Date _____

(11) WATER BEARING ZONES:

Depth at which water was first found 282 - 285

From	To	Estimated Flow Rate	SWL
282	285	30 gpm	42

(12) WELL LOG:

Ground elevation _____

Material	From	To	SWL
Brown clay argill	0	4	
Brown clay argill	4	10	
small sand stone boulders			
Hard gray sand stone	10	15	
brown sand stone	15	25	
gray basalt	25	85	
hard gray basalt	85	150	
gray basalt on white quartz	150	210	
gray basalt on white lime stone	210	290	42

Date started 9-24-90 Completed 9-27-90

(unbonded) Water Well Constructor Certification:

I certify that the work I performed on the construction, alteration, or abandonment of this well is in compliance with Oregon well construction standards. Materials used and information reported above are true to my best knowledge and belief.

WWC Number _____

Signed _____

Date _____

(bonded) Water Well Constructor Certification:

I accept responsibility for the construction, alteration, or abandonment work performed on this well during the construction dates reported above. All work performed during this time is in compliance with Oregon well construction standards. This report is true to the best of my knowledge and belief.

WWC Number 1271

Signed R. D. With

Date 10-2-90

FOR WATER RESOURCES DEPARTMENT USE ONLY

Date Postmarked 9-24-90
 Date Hand-delivered _____
 Watermaster Initials _____

W- 21854
 WRD Receipt 67362
 Date Fee Received 9-26-90

CHECK NO. _____

START CARD

NOTICE OF BEGINNING OF WELL CONSTRUCTION

(as required by ORS 537.762)

This form must be completed, signed by both the owner (or authorized agent) and constructor, and the original mailed or delivered to the Water Resources Department, 3850 Portland Road NE, Salem, OR 97310, no later than the day construction, alteration, conversion or abandonment work begins. A \$75 fee shall accompany all notices for new well construction or conversion of an existing hole not previously used as a water well (make checks payable to the Water Resources Department). Notices meeting this requirement but received without the required fee will not be accepted as properly and timely filed. The Water Resources Commission has authority to impose civil penalties for failure to submit the required \$75 fee with the start card and for failure to submit cards prior to beginning any construction, alteration, conversion or abandonment work.


Owner's name and mailing address LAWRENCE LAHM
4173 N.W. PEPPER TREE PL
CORVALLIS OR 97330

Check type of work: Fee Required ☒ New construction ☐ Conversion No Fee Required ☐ Repair ☐ Deepening ☐ Recondition ☐ Abandonment

Proposed Commencement Date ADJUST 25 SEP 1990 Existing or Proposed Well Depth 250' Diameter 6"

Check Use: ☒ Domestic ☐ Community ☐ Industrial ☐ Irrigation ☐ Monitoring ☐ Thermal ☐ Injection ☐ Other _____

Proposed Well Location: County BENTON Owner's Well Id. No. _____
 Township 11 (N or S) Range 5 (E or W) Section 29

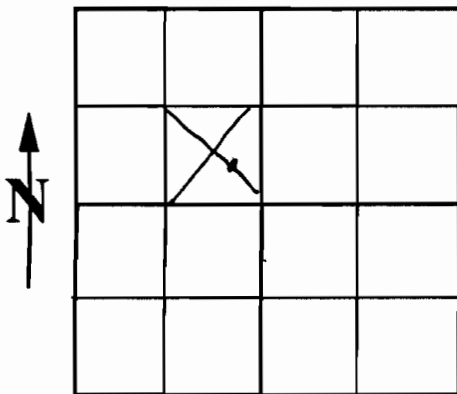

1. S.E. 1/4 of N.W. 1/4 of above section

2. Street address of well location GRANVIEW DRIVE
BENTON COUNTY

3. Tax lot number of well location T115-R5W-SEC. 29 B.D.

4. Attach map with location identified.
 (See reverse of this form for approved maps)

5. Show well location within 1/4, 1/4 of section grid at left.

We hereby certify that we have read the back of this form, and that to the best of our knowledge the information provided herein is accurate and the well is being properly located from septic tanks, septic drain fields and other hazards. (See #2 on back)

Lawrence LaHm
 Owner's signature

Raymond C. Gellately
 Bonded Water Well Constructor

OWNER 31 AUG 1990
 Title Date
758-7244
 Home phone Work phone

License No. 177
RAY GELLATELY & RON WITMAN
 Company WELL DRILLING

NOTE: This is not a water right application. The owner is responsible for obtaining a water right through the Water Resources Department, if required.

THIS COPY TO WATER RESOURCES DEPARTMENT IN SALEM
 If no fee applies, discard this copy

SEP 26 1990

WATER RESOURCES DEPT.
SALEM, OREGON


APPLICANT: Lawrence Lahm

FILE NUMBER: PC-88-16

SCALE: As shown


HEARING DATE: August 23, 1988

SITE MAP

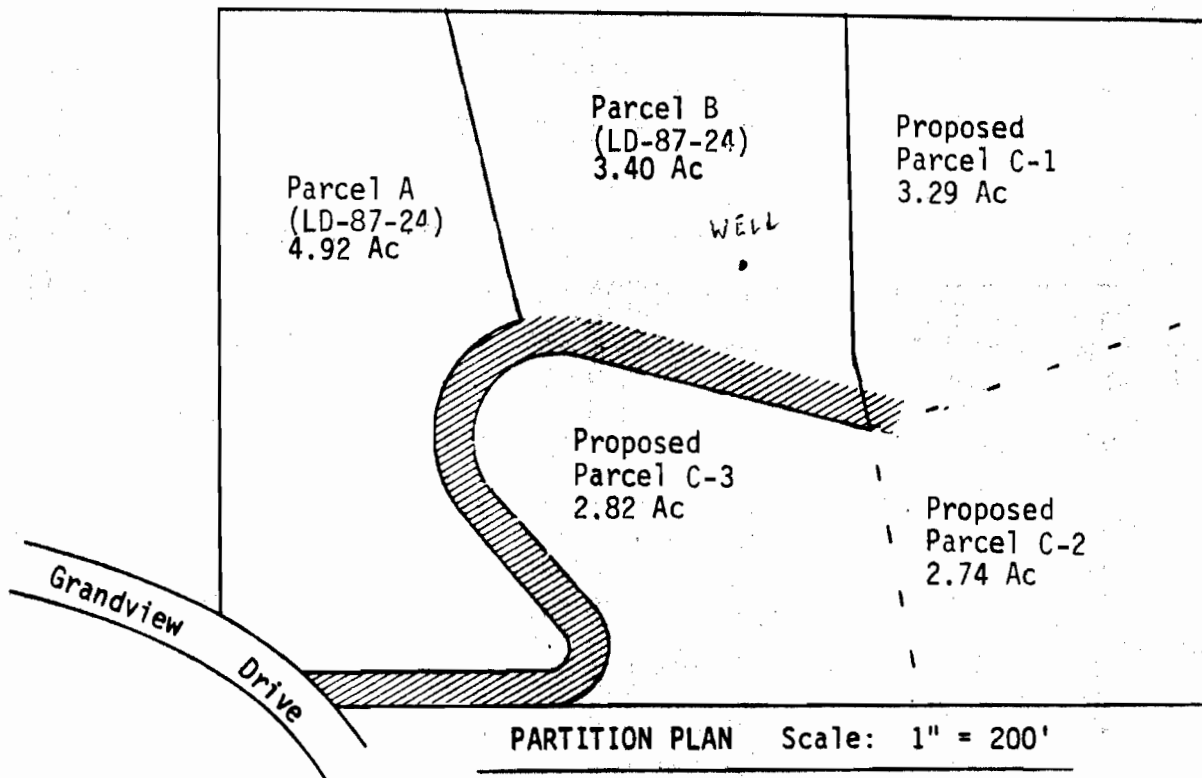


LEGEND

- Lahm Property
 Proposed 40' Access Easement
 Corvallis Urban Growth Boundary
 Zoning Boundary

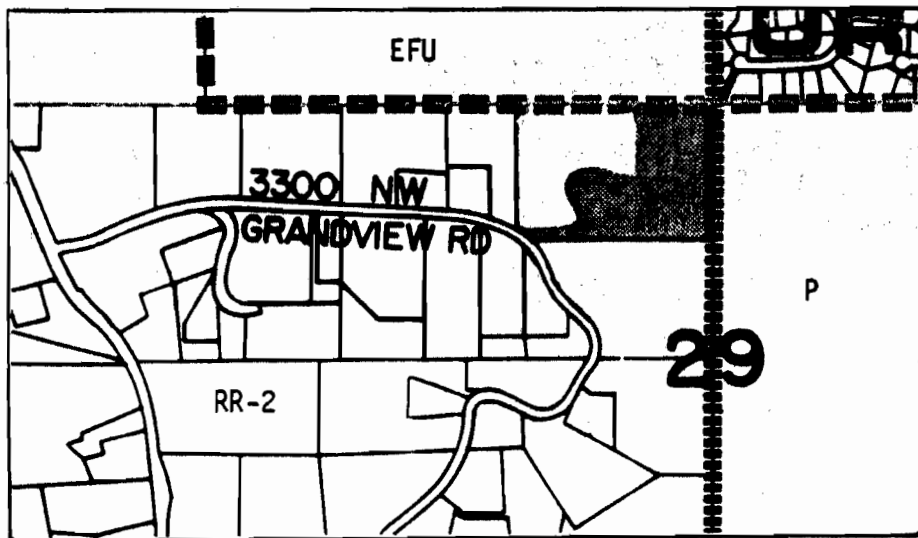

NEIGHBORHOOD MAP

Scale: 1" = 1,000'

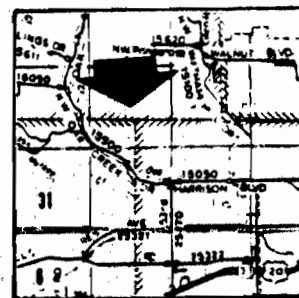

LOCATION MAP

T11S, R5W, Sec29

