

STATE ENGINEER
Salem, Oregon

Well Record

STATE WELL NO. 1/4-29P
COUNTY Clackamas
APPLICATION NO. GR-1401

GR- 1439

OWNER: Ernest Blaser

01004

MAILING

ADDRESS: Rt. 2, Box 80

CITY AND


STATE: Boring, Oregon

LOCATION OF WELL: Owner's No.

SE 1/4 SW 1/4 Sec. 29 T. 1 S. R. 4 E. W.M.

Bearing and distance from section or subdivision

corner 1060' N. & 1040' W. from S 1/4 cor. Sec. 29

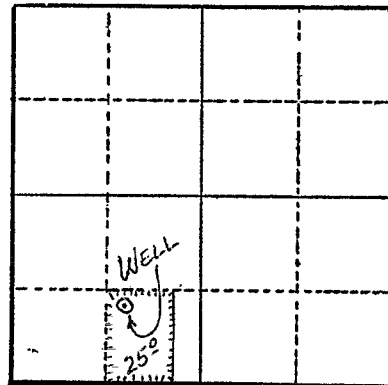

Section 29

Altitude at well 550'

TYPE OF WELL: Drilled Date Constructed 1952

Depth drilled 140' Depth cased 140'

CASING RECORD:

8"

FINISH:

Torch cut perforations 1/4" x 12" (4 cuts around) from 80 to 90 ft.
" " " " " " 120 to 140 ft.

AQUIFERS:

WATER LEVEL:

70'

PUMPING EQUIPMENT: Type Pacific submersible H.P. 6
Capacity 120 G.P.M.

WELL TESTS:

Drawdown 50 ft. after hours 120 G.P.M.

Drawdown 20 ft. after hours 60 G.P.M.

USE OF WATER Irrigation Temp. °F. 19

SOURCE OF INFORMATION GR Record

DRILLER or DIGGER

ADDITIONAL DATA:

Log Water Level Measurements Chemical Analysis Aquifer Test

REMARKS:

Log: Clay 0 to 50 ft.
Hard rock 50 to 80 ft.
Soft porous rock 80 to 115 ft. (water)
Cement gravel 115 to 140 ft. (water)

Irrigation of 25 acres.