

STATE ENGINEER
Salem, Oregon

CLAC
1006

01006 Well Record

STATE WELL NO. 1/4-29N
COUNTY CLACKAMAS
APPLICATION NO. GR-2685

OWNER: Rollie T. French

MAILING

ADDRESS: Rt. 2, Box 992

LOCATION OF WELL: Owner's No.


CITY AND

STATE: Troutdale, Oregon

SW 1/4 SW 1/4 Sec. 29 T. 1 N. 4 E. W.M.

Bearing and distance from section or subdivision

corner N. 654' W. 8'

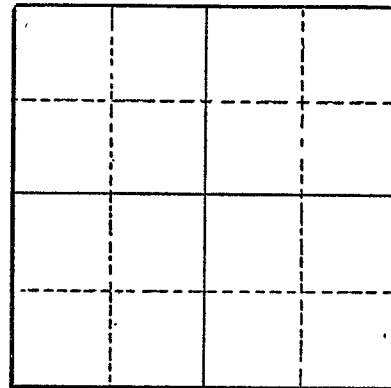

Section

Altitude at well

TYPE OF WELL: Drilled Date Constructed 1953

Depth drilled 91 Depth cased 87

CASING RECORD:

10-inch

FINISH:

AQUIFERS:

WATER LEVEL:

37-feet

PUMPING EQUIPMENT: Type Berkeley H.P. 3
Capacity 60 G.P.M.

WELL TESTS:

Drawdown 58 ft. after hours Pumping 75 G.P.M.

Drawdown ft. after hours G.P.M.

USE OF WATER irrigation Temp. °F. 19

SOURCE OF INFORMATION GR-2543

DRILLER or DIGGER Hamblet Drilling Co., 6116 S.E. 56th, Portland 7, Oregon

ADDITIONAL DATA:

Log Water Level Measurements Chemical Analysis Aquifer Test

REMARKS: