

STATE ENGINEER
Salem, Oregon

Well Record

CLAC

STATE WELL NO. 5/2-15H
COUNTY CLACKAMAS
APPLICATION NO. GR-2337

610214

OWNER: E. & O. G. Weidman


MAILING ADDRESS: Rt. 2, Box 310

LOCATION OF WELL: Owner's No.

CITY AND STATE: Molalla, Oregon

SE 1/4 NE 1/4 Sec. 15 T. 5S ^{N.} S., R. 2 ^{E.} W., W.M.

Bearing and distance from section or subdivision corner S. 20° W. 1615'

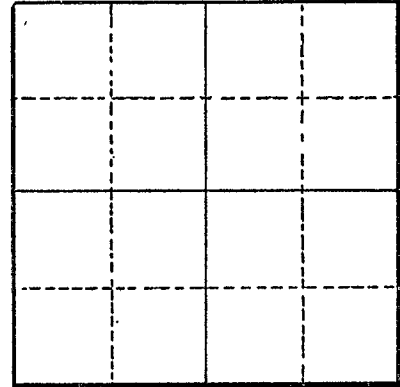

Section

Altitude at well

TYPE OF WELL: Dug Date Constructed 1953

Depth drilled 9 Depth cased

CASING RECORD:

FINISH:

AQUIFERS:

Dirt and gravel

WATER LEVEL:

2 1/2-feet

PUMPING EQUIPMENT: Type Pacific unit type centrifugal 1 1/4 H.P. 2
Capacity ? G.P.M.

WELL TESTS:

Drawdown 6 1/2 ft. after hours Pumping 80 G.P.M.
Drawdown ft. after hours G.P.M.

USE OF WATER Irrigation Temp. °F. 19

SOURCE OF INFORMATION GR-2221

DRILLER or DIGGER

ADDITIONAL DATA:

Log ^X Water Level Measurements Chemical Analysis Aquifer Test

REMARKS:

Dirt with small amount of water 4'
Hard Packed Gravel 1 1/2'
Loose Gravel and Boulders 3 1/2'