

STATE ENGINEER
Salem, Oregon

Well Record
CLAC

STATE WELL NO. 5/2-16N
COUNTY Clackamas
APPLICATION NO. GR-2428

OWNER: W. P. Wagner 010240


MAILING ADDRESS: Rt. 1, Box 62

LOCATION OF WELL: Owner's No.

CITY AND STATE: Molalla, Oregon

SW 1/4 SW 1/4 Sec. 16 T. 5 S., R. 2 E., W.M.

Bearing and distance from section or subdivision
corner .820' N. & 1300' E. from SW corner Sec. 16

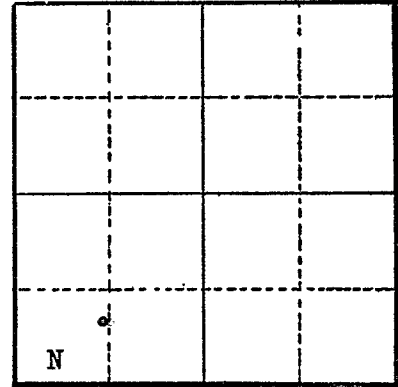

Section 16

Altitude at well 350'

TYPE OF WELL: drilled Date Constructed 1950

Depth drilled 80' Depth cased 70'

CASING RECORD:

6-inch

FINISH:

AQUIFERS:

WATER LEVEL:

80'

PUMPING EQUIPMENT: Type Pumpjack H.P. 3
Capacity 30 G.P.M.

WELL TESTS:

Drawdown 40 ft. after hours 20 G.P.M.

Drawdown ft. after hours G.P.M.

USE OF WATER Irrigation Temp. °F., 19

SOURCE OF INFORMATION GR-3996

DRILLER or DIGGER Westerberg Well Drilling, Mulino, Oregon

ADDITIONAL DATA:

Log NA Water Level Measurements Chemical Analysis Aquifer Test

REMARKS: