

STATE ENGINEER
Salem, Oregon

Well Record

STATE WELL NO. 5/2-20N(1)
COUNTY Clackamas
APPLICATION NO. GR-69


OWNER: Ronald H. Arnold MAILING ADDRESS: _____

LOCATION OF WELL: Owner's No. 1 CITY AND STATE: Molalla, Oregon

SE $\frac{1}{4}$ NE $\frac{1}{4}$ Sec. 20 T. 5 S. R. 2 E., W.M.

Bearing and distance from section or subdivision

corner 225' W. & 75' N. from SE cor. NE $\frac{1}{4}$
Sec. 20, T. 5 S., R. 2 E., W. M.

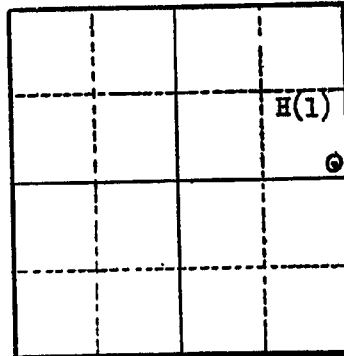

Altitude at well 360' Interpolated

TYPE OF WELL: Drilled Date Constructed Dec. '52

Depth drilled 327' Depth cased 250'

Section 20

CASING RECORD:

6 inch casing set from 0 to 250 feet

FINISH:

None

AQUIFERS:

Coal bed (lignite) from 320 to 327'

WATER LEVEL:

307 feet below surface of ground January, 1955

PUMPING EQUIPMENT: Type Sumo Submersible H.P. 3.6
Capacity 20 G.P.M.

WELL TESTS:

Drawdown 1 $\frac{1}{4}$ ft. after _____ hours 20 G.P.M.

Drawdown _____ ft. after _____ hours _____ G.P.M.

USE OF WATER Irrigation & domestic 5 acs comp. °F. _____, 19 _____

SOURCE OF INFORMATION Registration Statement GR-69

DRILLER or DIGGER William J. Stennett 361 Warner Milne Road, Oregon City

ADDITIONAL DATA:

Log x Water Level Measurements _____ Chemical Analysis _____ Aquifer Test _____

REMARKS:

CLAC
10345

County **Clackamas**

Application No. GR-69

Owner: Ronald H. Arnold Owner's No. 1

Driller: William J. Stennett Date Drilled December 1952

[illegible]