

STATE ENGINEER
Salem, Oregon

CLAC 01052

Well Record

STATE WELL NO. 1/4-30E
COUNTY Clackamas
APPLICATION NO. GR-3907

OWNER: Donald Arthur Dickinson


MAILING ADDRESS: Route 2, Box 195

LOCATION OF WELL: Owner's No.

CITY AND STATE: Boring, Oregon

SW 1/4 NW 1/4 Sec. 30 T. 1 S, R. 4 W, W.M.

Bearing and distance from section or subdivision corner N. 10°00' E., W. 1/4 Cor. Sec. 30, 800'

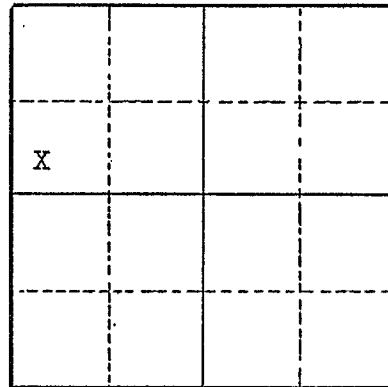

Section 30

Altitude at well

TYPE OF WELL: Drilled Date Constructed Mar., 1953

Depth drilled 155 ft. Depth cased 155 ft.

CASING RECORD:

6 inch steel casing set to 155 feet

FINISH:

No perforations

AQUIFERS:

WATER LEVEL:

137 feet below surface

PUMPING EQUIPMENT: Type Jacuzzi turbine H.P. 5
Capacity 108 G.P.M.

WELL TESTS:

Drawdown ft. after hours G.P.M.
Drawdown ft. after hours G.P.M.

USE OF WATER Irrigation Temp. °F., 19

SOURCE OF INFORMATION Well Registration Statement Cert. # GR-3547

DRILLER or DIGGER C. E. Hamblett

ADDITIONAL DATA:

Log Water Level Measurements Chemical Analysis Aquifer Test

REMARKS: