

STATE ENGINEER  
Salem, Oregon

# Well Record

STATE WELL NO. 1/4-30G  
COUNTY CLACKAMAS  
APPLICATION NO. GR-2924

CLAC  
01054

OWNER: L. R. Lane


MAILING ADDRESS: Rt. 2, Box 167

LOCATION OF WELL: Owner's No.

CITY AND STATE: Boring, Oregon

SW 1/4 NE 1/4 Sec. 30 T. 1 N. 4 E. S, R. W, W.M.

Bearing and distance from section or subdivision corner S. 55° 0' W. 2320'

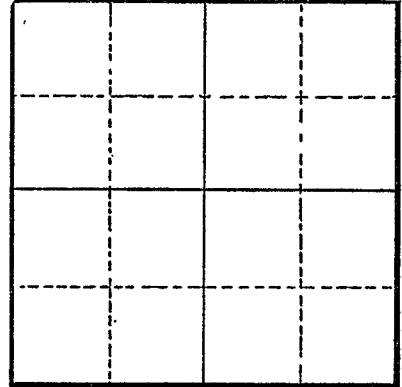

Section

Altitude at well

TYPE OF WELL: drilled Date Constructed 1950

Depth drilled 194 Depth cased 194

### CASING RECORD:

8-inch

### FINISH:

### AQUIFERS:

Soil, rock, clay and shale

### WATER LEVEL:

80-feet

PUMPING EQUIPMENT: Type Peerless H.P. 7 1/2  
Capacity 66 G.P.M.

### WELL TESTS:

Drawdown ft. after hours G.P.M.  
Drawdown ft. after hours G.P.M.

USE OF WATER Irrigation Temp. °F., 19

SOURCE OF INFORMATION GR-2753

DRILLER or DIGGER Haakon Bottner, 11544 N.E. Glisan, Portland, Oregon

### ADDITIONAL DATA:

Log  Water Level Measurements  Chemical Analysis  Aquifer Test

### REMARKS:

Soil	95	95
Rock	40	135
Clay	20?	155
Shale	39?	194