


STATE ENGINEER
Salem, Oregon

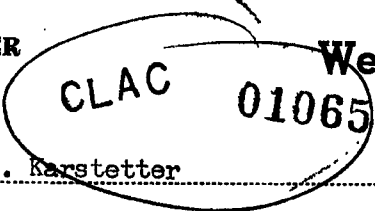

Well Record

STATE WELL NO. 1/4-30N
COUNTY CLACKAMAS
APPLICATION NO. GR-1918

OWNER: John J. Karstetter


MAILING ADDRESS: Route 2, Box 218

LOCATION OF WELL: Owner's No.

CITY AND STATE: Boring, Oregon

SW 1/4 SW 1/4 Sec. 30 T. 1 S., R. 4 E., W.M.

Bearing and distance from section or subdivision corner 650' N & 850' E of SW cor of section 30

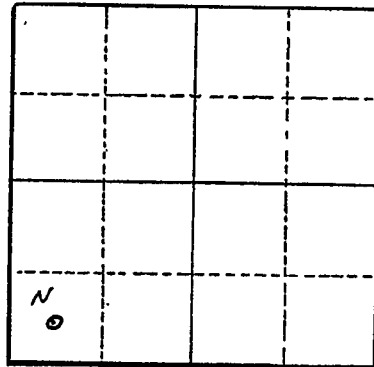

Altitude at well

TYPE OF WELL: Drilled Date Constructed 1951

Depth drilled 278' Depth cased

Section 30

CASING RECORD:

FINISH: 8" perforated Casings

AQUIFERS:

WATER LEVEL: 100'

PUMPING EQUIPMENT: Type Stage Turbine H.P. 15
Capacity 250 G.P.M.

WELL TESTS:
Drawdown 40 ft. after hours 250 G.P.M.
Drawdown ft. after hours G.P.M.

USE OF WATER Irrigation Temp. °F. 19

SOURCE OF INFORMATION GR-3865

DRILLER or DIGGER A. O. Olson

ADDITIONAL DATA:
Log NA Water Level Measurements Chemical Analysis Aquifer Test

REMARKS:

#1

FOLDING INSTRUCTIONS

CLAC 1065

WELL NO. 1

To fit No. 10 window envelopes - fold along bottom of shaded strip.
To fit regular No. 10 window envelopes - fold along top of shaded strip.

A. O. OLSEN WELL DRILLING, INC.

18211 S. E. Powell
GRESHAM, OREGON 97030

No 0344

TO

637-655-3353

Water well for
John Karstetter,
Drilled 1956.

DATE
CUSTOMER ORDER NO.
SALESMAN
VIA

TERMS:

QUANTITY	DESCRIPTION	PRICE	AMOUNT
8'	irrigation well drilled to 275'	static	98'
	Red clay - 0-40'		
	bedrock - 40'-160'		
	cemented gravel 160-240	water bearing,	
	clay + gravel - 240-275 - dry.		
	Cased to 240' with 8" pipe.		
	Perforated 160'-240'		
	Pump Test 160 g.p.m. with 47' DD.		

ORIGINAL

Thank You!

A. O. Olsen.

RECEIVED

NOV 06 2000

WATER RESOURCES DEPT.
SALEM, OREGON

RECEIVED

JAN 16 2001

WATER RESOURCES DEPT.
SALEM, OREGON

RECEIVED
NOV 30 1992
HANER, ROSS & SPURSEN, INC