

STATE ENGINEER
Salem, Oregon

Well Record

STATE WELL NO. 1/4-32
COUNTY Clackamas
APPLICATION NO. GR-2686

CLAC

01132

OWNER: Dwight William Bergh

MAILING

ADDRESS: Route 1, Box 43

LOCATION OF WELL: Owner's No.

CITY AND

STATE: Boring, Oregon

SW Corner $\frac{1}{4}$ SE $\frac{1}{4}$ Sec. 32 T. 1 S., R. 4 E., W.M.


Bearing and distance from section or subdivision

corner

Altitude at well

TYPE OF WELL: drilled Date Constructed 1952

Depth drilled 214 Depth cased 187

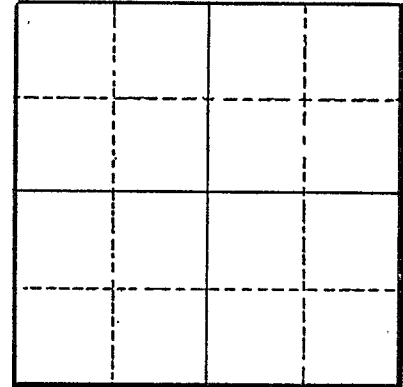

Section

CASING RECORD:

8 inch

FINISH:

3/16 x 2 1/4 - 4 holes per foot from 110 to 175

AQUIFERS:

gravel

WATER LEVEL:

45 feet

PUMPING EQUIPMENT: Type Jacuzzi Submersible H.P. 7 1/2
Capacity 65 G.P.M.

WELL TESTS:

Drawdown 100 ft. after hours pumping 65 G.P.M.

Drawdown ft. after hours G.P.M.

USE OF WATER irrigation Temp. °F. 19

SOURCE OF INFORMATION GR-2544

DRILLER or DIGGER A. O. Olsen, Rt., Box 565, Gresham, Oregon

ADDITIONAL DATA:

Log X Water Level Measurements Chemical Analysis Aquifer Test

REMARKS:

Cement gravel from 100' to 185'