

STATE ENGINEER  
Salem, Oregon

CLAC  
01152

# Well Record

STATE WELL NO. 1/4-32P  
COUNTY Clackamas  
APPLICATION NO. GR-3961

OWNER: Lester E. Harrington


MAILING ADDRESS: Route 1, Box 474

LOCATION OF WELL: Owner's No.

CITY AND STATE: Boring, Oregon

SE 1/4 SW 1/4 Sec. 32 T. 1 N. S, R. 4 E. W., W.M.

Bearing and distance from section or subdivision corner 990 feet North and 30 feet West from the S 1/4 Corner, Section 32, thence west 225 ft. thence south 200 feet to the well.

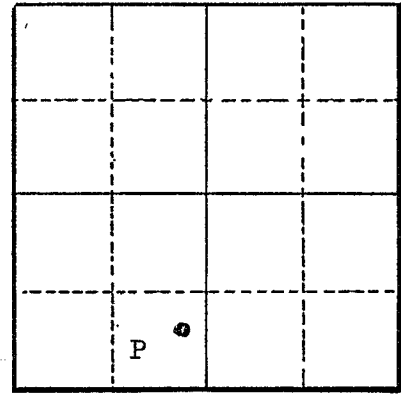

Section 32

Altitude at well 400 feet

TYPE OF WELL: Drilled Date Constructed Sept. 1947

Depth drilled 78 feet Depth cased 78 feet

### CASING RECORD:

8-inch iron casing set from 1 to 78 feet

### FINISH:

15-1/4" perforations per foot from 25 to 78 feet

### AQUIFERS:

### WATER LEVEL:

25 feet

PUMPING EQUIPMENT: Type Joucsia Jet 3" H.P.  
Capacity 40 G.P.M.

### WELL TESTS:

Drawdown 0 ft. after \_\_\_\_\_ hours 60 G.P.M.  
Drawdown \_\_\_\_\_ ft. after \_\_\_\_\_ hours \_\_\_\_\_ G.P.M.

USE OF WATER Industrial & Irrigation Temp. \_\_\_\_\_ °F., 19

SOURCE OF INFORMATION GR-4088

DRILLER or DIGGER O. B. Olson Gresham, Oregon

### ADDITIONAL DATA:

Log (NA) Water Level Measurements \_\_\_\_\_ Chemical Analysis \_\_\_\_\_ Aquifer Test \_\_\_\_\_

### REMARKS: