

WATER WELL REPORT 011500

CLACK 45/4-18 C(1)

File Original and First Copy with the STATE ENGINEER, SALEM, OREGON

STATE OF OREGON

State Well No. State Permit No.

(1) OWNER:

Name Clackamas County
Address Courthouse
Oregon City, Oregon

(2) LOCATION OF WELL:

County CLACKAMAS Owner's number, if any-
N-E 1/4 N.W 1/4 Section 18 T. 45 R. 4 E W.M.
Bearing and distance from section or subdivision corner
S. 76° 05' W. 860' from
1/4 corner on North line of
Section 18, T. 45., R. 4 E.

(3) TYPE OF WORK (check):

New Well [checked] Deepening [] Reconditioning [] Abandon []
If abandonment, describe material and procedure in Item 11.

PROPOSED USE (check):

Domestic [checked] Industrial [] Municipal []
Irrigation [] Test Well [] Other []

(5) TYPE OF WELL:

Rotary [] Driven []
Cable [] Jetted []
Dug [] Bored []

(6) CASING INSTALLED:

6" Diam. from 0 ft. to 53' ft. Gage 17.02
" Diam. from ft. to ft. Gage
" Diam. from ft. to ft. Gage

(7) PERFORATIONS:

Perforated? [] Yes [checked] No
Type of perforator used
SIZE of perforations in. by in.
perforations from ft. to ft.
perforations from ft. to ft.
perforations from ft. to ft.
perforations from ft. to ft.
perforations from ft. to ft.

(8) SCREENS:

Well screen installed [] Yes [checked] No
Manufacturer's Name
Type Model No.
m. Slot size Set from ft. to ft.
Slot size Set from ft. to ft.

(9) CONSTRUCTION:

Was well gravel packed? [] Yes [checked] No Size of gravel:
Gravel placed from ft. to ft.
Was a surface seal provided? [checked] Yes [] No To what depth? 25 ft.
Material used in seal- GROUT
Did any strata contain unusable water? [] Yes [checked] No
Type of water? Depth of strata
Method of sealing strata off

(10) WATER LEVELS:

Static level 10 ft. below land surface Date 7/20/60
Artesian pressure lbs. per square inch Date

Log Accepted by:

[Signed] [Signature] Date 7-22-60

(11) WELL TESTS:

Drawdown is amount water level is lowered below static level
Was a pump test made? [] Yes [checked] No If yes, by whom?
Yield: gal./min. with ft. drawdown after hrs.
Bailer test 20 gal./min. with 20 ft. drawdown after 2 hrs.
Artesian flow g.p.m. Date
Temperature of water 52 Was a chemical analysis made? [] Yes [] No

(12) WELL LOG:

Diameter of well 6 inches.
Depth drilled 60 ft. Depth of completed well 53 ft.

Formation: Describe by color, character, size of material and structure, and show thickness of aquifers and the kind and nature of the material in each stratum penetrated, with at least one entry for each change of formation.

Table with columns: MATERIAL, FROM, TO. Rows include TOPSOIL, HEAVY GRAVEL, BLUE CLAY, BLUE SOAPSTONE, SAND WITH WATER, SOAPSTONE, COLORED SAND WITH WATER - SANDSTONE.

RECEIVED AUG 1 1960 STATE ENGINEER SALEM OREGON

Work started July 19 1960 Completed July 21 1960

(13) PUMP:

Manufacturer's Name Fairbanks Morse
Type Jet H.P. 1/2

Well Driller's Statement:

This well was drilled under my jurisdiction and this report is true to the best of my knowledge and belief.


NAME W.M. J. STENNETT
(261 W. Main St., Salem, Ore.) (Type or print)
Ph. 2113, Oregon City, Ore.

Address

Driller's well number

[Signed] William J. Stennett (Well Driller)

License No. 5 Date July 21 1960

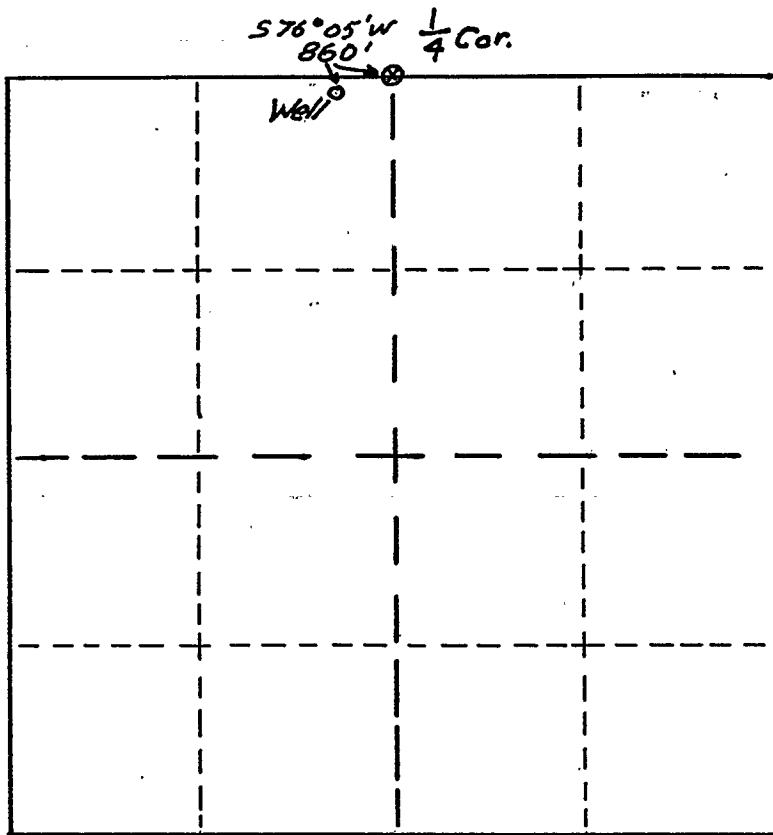

LOCATION of DRILLED WELL
 METSLER PARK
 Sec. 18 T4S R4E
 Scale 4" = 1 mile

RECEIVED
 AUG 1 1960
 STATE ENGINEER
 SALEM, OREGON