

STATE ENGINEER
Salem, Oregon

011845

Well Record

CLAC

STATE WELL NO. 4/4-23
COUNTY MULTNOMAH
APPLICATION NO. GR-2566

OWNER: Milton A. Dunham and Dora E. Dunham MAILING ADDRESS: 5534 N.E. Thompson St.

LOCATION OF WELL: Owner's No. CITY AND STATE: Portland, Oregon

N $\frac{1}{2}$ NW $\frac{1}{4}$ NW $\frac{1}{4}$ Sec. 23 T. 4 S. R. 4 E. W.M.

Bearing and distance from section or subdivision corner 400' E. & 250' S.

Altitude at well

TYPE OF WELL: Dug Date Constructed 1951

Depth drilled 43 Depth cased 10

CASING RECORD:

48-inch

FINISH:

Open well

AQUIFERS:

Clay and lava

WATER LEVEL:

32-feet

PUMPING EQUIPMENT: Type Jacuzzi Jet H.P. $\frac{1}{2}$
Capacity 11 $\frac{1}{2}$ G.P.M.

WELL TESTS:

Drawdown ft. after hours G.P.M.
Drawdown ft. after hours G.P.M.

USE OF WATER Irrigation Temp. °F. 19

SOURCE OF INFORMATION GR-2425


DRILLER or DIGGER

ADDITIONAL DATA:

Log ☒ Water Level Measurements Chemical Analysis Aquifer Test

REMARKS:

Clay and lava

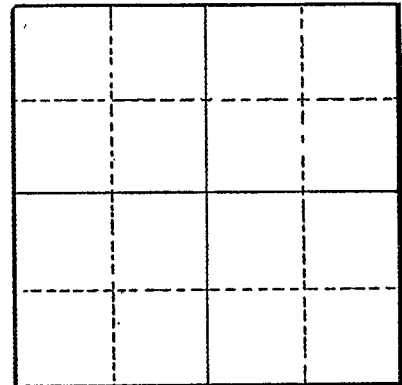

Section