

STATE ENGINEER
Salem, Oregon

CLAC
011990

Well Record

GR-1050

STATE WELL NO. 3/1-31A(1)
COUNTY Clackamas
APPLICATION NO. GR-1089

OWNER: Ross L. Rider


MAILING ADDRESS: Rt. 3, Box 279

LOCATION OF WELL: Owner's No. #2

CITY AND STATE: Canby, Oregon

NE 1/4 NE 1/4 Sec. 31 T. 3 S., R. 1 E., W.M.

Bearing and distance from section or subdivision corner 340' S. & 240' W. from NE cor. Sec. 31.

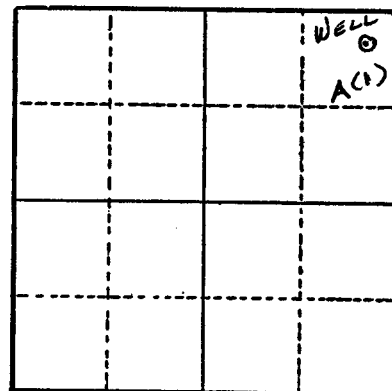

Section 31

Altitude at well 80 ft.

TYPE OF WELL: Dug Date Constructed 1950

Depth drilled 8 ft. Depth cased 8 ft.

CASING RECORD:

8x 10 in. plank box.

FINISH:

AQUIFERS:

WATER LEVEL:

PUMPING EQUIPMENT: Type RainMaster Cent. H.P. 12
Capacity 200 G.P.M.

WELL TESTS:

Drawdown 5 ft. after hours 200 G.P.M.
Drawdown ft. after hours G.P.M.

USE OF WATER Irrigation Temp. °F., 19

SOURCE OF INFORMATION G. R. Record

DRILLER or DIGGER

ADDITIONAL DATA:

Log N.A. Water Level Measurements Chemical Analysis Aquifer Test

REMARKS:

Irrigation of 18 Acres.