

STATE ENGINEER
Salem, Oregon

CLAC
011992

Well Record

GR-1051

STATE WELL NO. 3/1-31G(1)
COUNTY Clackamas
APPLICATION NO. GR-1090

OWNER: Ross L. Rider

MAILING ADDRESS:

Rt. 3, Box 279


LOCATION OF WELL: Owner's No. #1

CITY AND STATE:

Canby, Oregon

SW 1/4 NE 1/4 Sec. 31 T. 3 S., R. 1 E., W.M.

Bearing and distance from section or subdivision corner 350' N. & 1400' W. from E¹/₄ cor. Sec. 31.

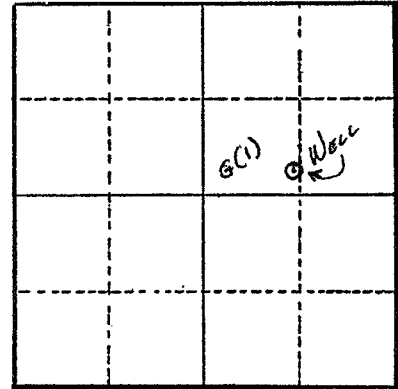

Section 31

Altitude at well 85 ft.

TYPE OF WELL: Dug Date Constructed 1954

Depth drilled 12 ft. Depth cased 12 ft.

CASING RECORD:

60 inch

FINISH:

AQUIFERS:

WATER LEVEL:

10 ft.

PUMPING EQUIPMENT: Type A.C. H.P. 15

Capacity 500 G.P.M.

WELL TESTS:

Drawdown 6 ft. after 450 hours G.P.M.

Drawdown ft. after hours G.P.M.

USE OF WATER Irrigation Temp. °F., 19

SOURCE OF INFORMATION G. R. Record

DRILLER or DIGGER

ADDITIONAL DATA:

Log Water Level Measurements Chemical Analysis Aquifer Test

REMARKS:

Log: Beaver dam 0 to 6 ft.
Gravel 6 to 12 ft.

Irrigation of 50 acres.