

STATE ENGINEER
Salem, Oregon

Well Record

STATE WELL NO. 3/1-31H
COUNTY Clackamas
APPLICATION NO. GR-3044

CLAC
011993

OWNER: Jack L. Rider


MAILING ADDRESS: Route 3, Box 268

LOCATION OF WELL: Owner's No.

CITY AND STATE: Canby, Oregon

SE $\frac{1}{4}$ NE $\frac{1}{4}$ Sec. 31 T. 3 S., R. 1 ~~W.~~ ^{N.} E. W.M.

Bearing and distance from section or subdivision corner 846' N. and 306' W. from E $\frac{1}{4}$ Cor. Sec. 31

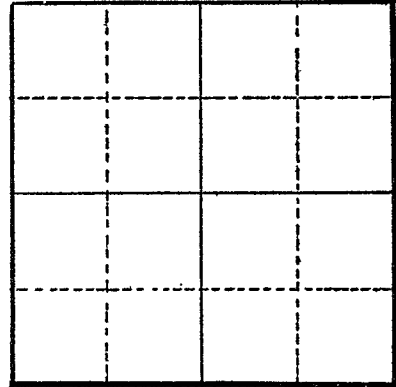

Section

Altitude at well

TYPE OF WELL: dug Date Constructed 1954

Depth drilled 15 Depth cased 12' & 15'

CASING RECORD:

32 inches, steel casing
32 inches, open hole

FINISH:

AQUIFERS:

sand and gravels

WATER LEVEL:

5 feet

PUMPING EQUIPMENT: Type centrifugal 4" H.P. 5
Capacity 200 G.P.M.

WELL TESTS:

Drawdown 2 ft. after hours pumping 300 G.P.M.
Drawdown ft. after hours G.P.M.

USE OF WATER Irrigation Temp. °F., 19.....

SOURCE OF INFORMATION GR-2850

DRILLER or DIGGER

ADDITIONAL DATA:

Log x Water Level Measurements Chemical Analysis Aquifer Test

REMARKS:

sand and gravel