

STATE ENGINEER
Salem, Oregon

CLAC
011994

Well Record

STATE WELL NO. 3/1-31K
COUNTY Clackamas
APPLICATION NO. GR-4017

OWNER: Allen F. Dutra


MAILING ADDRESS: P.O. Box 925

LOCATION OF WELL: Owner's No.

CITY AND STATE: Canby, Oregon

NW 1/4 SE 1/4 Sec. 31 T. 3 S., R. 1 E., W.M.

Bearing and distance from section or subdivision corner 925' N. 21°0' to center point

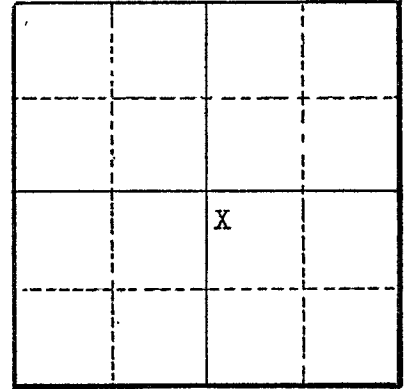

Section 31

Altitude at well

TYPE OF WELL: Dug Date Constructed 8/15/51

Depth drilled 18 ft. Depth cased 18 ft.

CASING RECORD:

60 inch diameter casing to 18 feet

FINISH:

AQUIFERS:

WATER LEVEL:

3 feet below surface

PUMPING EQUIPMENT: Type Allis Chalmers H.P. 15
Capacity 450 G.P.M.

WELL TESTS:

Drawdown 12 ft. after 200 hours G.P.M.
Drawdown ft. after hours G.P.M.

USE OF WATER Irrigation Temp. °F. 19

SOURCE OF INFORMATION Well Registration Statement Cert. # GR-3620

DRILLER or DIGGER Paul Collins

ADDITIONAL DATA:

Log Water Level Measurements Chemical Analysis Aquifer Test

REMARKS:

Log: 2 feet dirt and balance gravel and sand