

STATE ENGINEER
Salem, Oregon

CLAC
011995

Well Record


STATE WELL NO. 3/1-31Q(1)
COUNTY Clackamas
APPLICATION NO. GR-797

OWNER: Lester B. Cowgill
MAILING ADDRESS: Route 3, Box 296

LOCATION OF WELL: Owner's No. #B
CITY AND STATE: Canby, Oregon

SW 1/4 SE 1/4 Sec. 31 T. 3 N. S., R. 1 E., W.M.

Bearing and distance from section or subdivision
corner 1000' E. and 200' N. from NW corner of
Section 6, T. 4 S., R. 1 E., W. M.

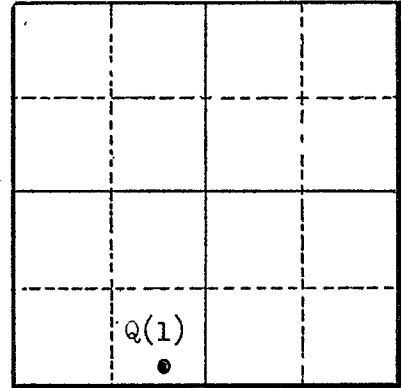

Section 31

Altitude at well 100'

TYPE OF WELL: Dug Date Constructed 1928

Depth drilled 12' Depth cased 12'

CASING RECORD:

5' x 5' timber cribbed

FINISH:

AQUIFERS:

WATER LEVEL:

0 to 8 feet

PUMPING EQUIPMENT: Type Gas engine - Bingham Cent. H.P. 5
Capacity 225 G.P.M.

WELL TESTS:

Drawdown 0-8 ft. after hours 225 G.P.M.
Drawdown ft. after hours G.P.M.

USE OF WATER Irrigation Temp. °F., 19

SOURCE OF INFORMATION GR-797

DRILLER or DIGGER

ADDITIONAL DATA:

Log Below Water Level Measurements Chemical Analysis Aquifer Test

REMARKS:

Clay soil 0 - 5'
Gravel 5 - 12'