

STATE ENGINEER  
Salem, Oregon

CLAC  
011996

# Well Record

STATE WELL NO. 3/1-310(2)  
COUNTY Clackamas  
APPLICATION NO. GR-797

OWNER: Lester B. Cowgill  
MAILING ADDRESS: Route 3, Box 296

LOCATION OF WELL: Owner's No. #C  
CITY AND STATE: Canby, Oregon


SW 1/4 SE 1/4 Sec. 31 T. 3 N. S. R. 1 E. W., W.M.

Bearing and distance from section or subdivision  
corner 190' NE of SW corner of Sec. 31

Altitude at well 100'

TYPE OF WELL: Dug Date Constructed 1926

Depth drilled 10' Depth cased 10'

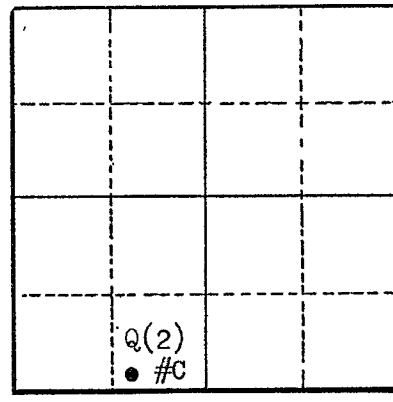

### CASING RECORD:

4' x 6' timber cribbed

### FINISH:

### AQUIFERS:

### WATER LEVEL:

PUMPING EQUIPMENT: Type Gas engine - Bingham cent. pump H.P. 5  
Capacity 225 G.P.M.

WELL TESTS:  
Drawdown 4 ft. after 350 hours G.P.M.  
Drawdown (changes during season) hours G.P.M.

USE OF WATER Irrigation Temp. °F. 19

SOURCE OF INFORMATION GR-799

DRILLER or DIGGER

ADDITIONAL DATA:  
Log Below Water Level Measurements Chemical Analysis Aquifer Test

### REMARKS:

Top muck soil in Pudding River overflow channel 0 - 3'  
Peat formation (very porous) 3 - 10'